

## **INVITATION FOR BIDS**

CCK-2687-23 ADDENDUM# 8 03/20/2023

ATTENTION: This is not an order. Read all instructions, terms and conditions carefully.

IMPORTANT: BID AND ADDENDUM MUST BE RECEIVED BY: 03/28/2023 @ 3:00 P.M. LEXINGTON, KY TIME


Bidder must acknowledge receipt of this and any addendum as stated in the Invitation for Bids.

- 1. Please refer to and incorporate into your bid the attached questions and answers and updated drawing provide by the Project Team.
- 2. If you have any questions, please contact Ken Scott at the number below or at <a href="mailto:cckbidquestions@uky.edu">cckbidquestions@uky.edu</a>.

OFFICIAL APPROVAL UNIVERSITY OF KENTUCKY	<u>SIGNATURE</u>
Ken Scott 03/20/2023	
Ken Scott / (859) 257-9102	Typed or Printed Name


University of Kentucky Purchasing Division 322 Peterson Service Building Lexington, KY 40506-0005

Question Date	Question #	Question	Responder	Response
2/28/2023	1.	Are the complete PRV stations and steam coil hook ups to be demoed and replaced? Please confirm, the drawings are confusing, because the demo to symbol and connect to existing say otherwise.	СМТА	Refer to addendum #5 and #8 drawings for demolition scope of prv and coil connections.
	2.	Do the PRV station #1,2,4,5,6 get completely replaced ?	СМТА	Refer to addendum #5 and #8 drawings. PRV stations #1, #2 and #6 are replaced complete in their respective phases. #4 and #5 only piping to the PRV.
	3.	Any work associated with PRV #3, it appears on the schedule, but not on drawings is it included in this project?	CMTA	Refer to revised m3.0 addendum #8.
	4.	Please schedule PRV #5 sizes.	CMTA	Refer to revised m3.0 addendum #8.
	5.	Please provide pipe sizes "D,E,F,G,H" for PRVs 1 & 4.	CMTA	Refer to revised m3.0 addendum #8.
	6. 7.	Is the upper detail of the PRVs shown on drawing M3.0 for PRVs 2,3, & 5?  We assume any asbestos abatement will be handle by the owner	CMTA CMTA	Refer to revised m3.0 addendum #8. Yes

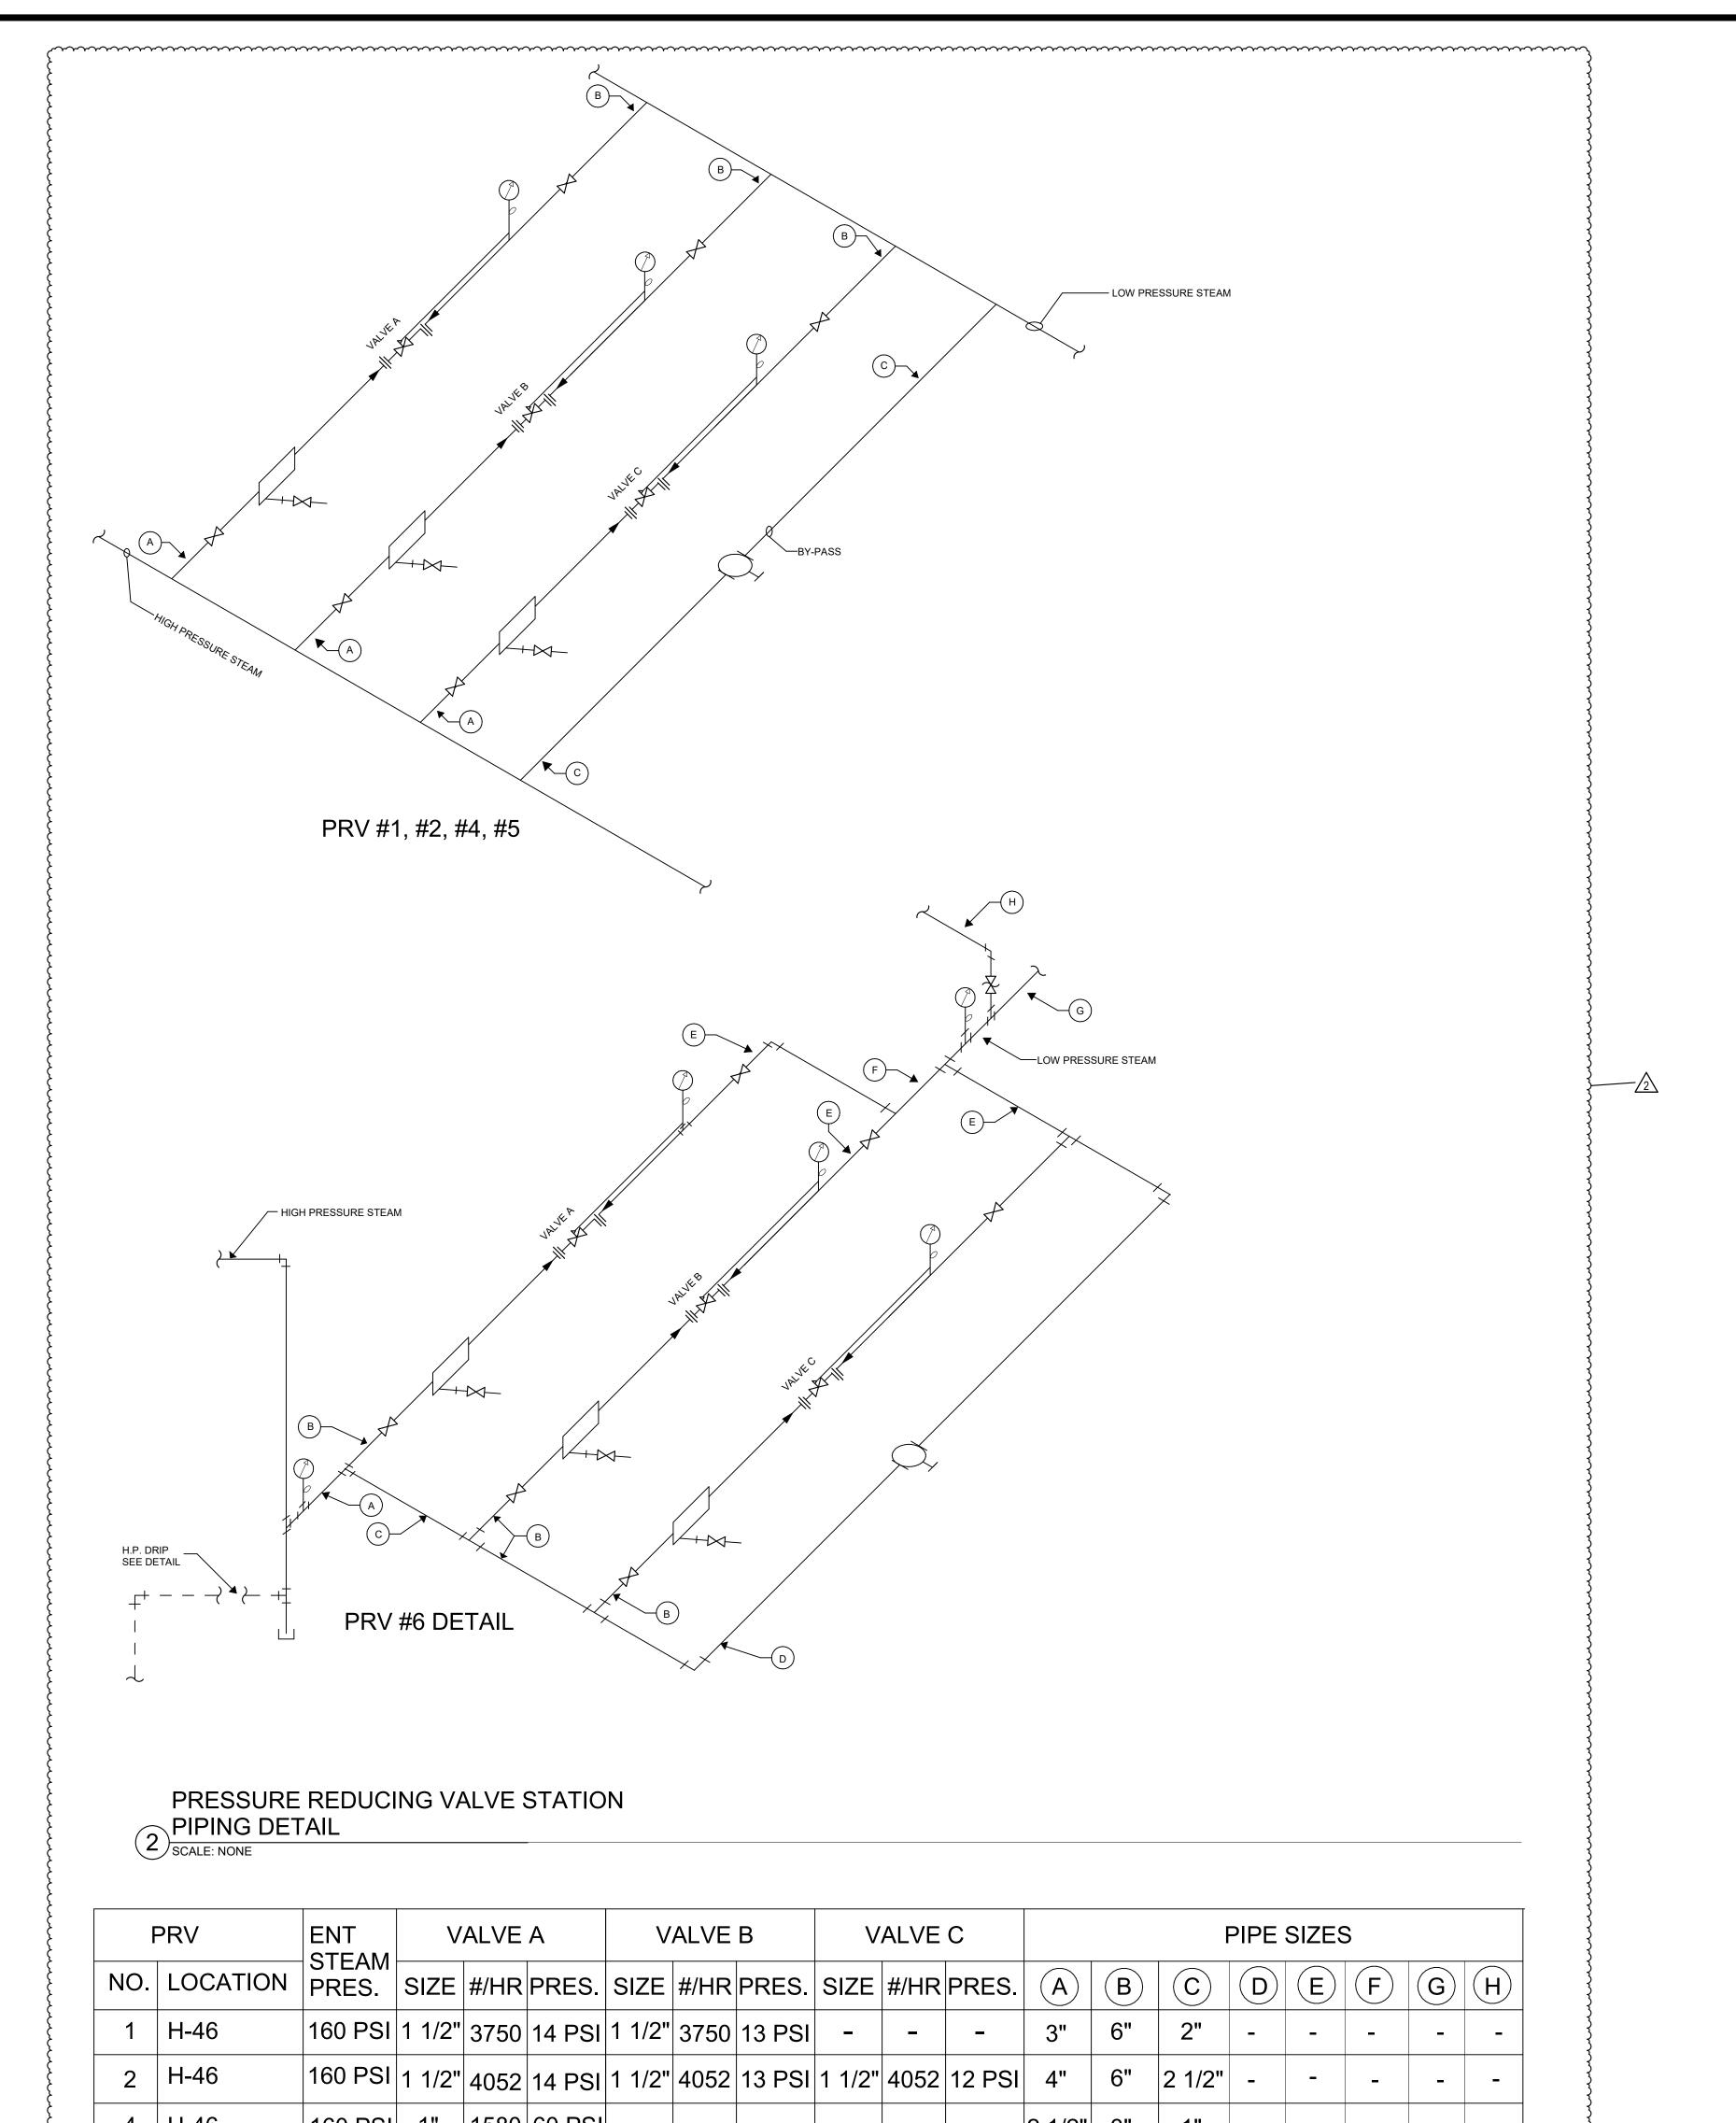


	PRV	ENT		ALVE	А	V	VALVE B		VALVE C		PIPE SIZES								
NO	LOCATION	STEAM PRES.		#/HR	PRES.	SIZE	#/HR	PRES.	SIZE	#/HR	PRES.	A	B	C	D	Ш	F	G	(H)
1	H-46	160 PSI	1 1/2"	3750	14 PSI	1 1/2"	3750	13 PSI	_	_	_	3"	6"	2"	1	1	-	-	•
2	H-46	160 PSI	1 1/2"	4052	14 PSI	1 1/2"	4052	13 PSI	1 1/2"	4052	12 PSI	4"	6"	2 1/2"	1	ı	•	-	I
4	H-46	160 PSI	1"	1580	60 PSI	-	-	_	-	-	-	2 1/2"	3"	1"	-	I	•	-	I
5	H-46	160 PSI	1"	1600	25 PSI	_	-	-	_	_	_	2 1/2"	4"	1"	-	1	-	-	-
6	H-46	160 PSI	1 1/2"	4160	7 PSI	1 1/2"	4160	6 PSI	1 1/2"	4160	6 PSI	5"	3"	4"	3"	6"	8"	8"	8"

STEAM PRESSURE REDUCING STATION 1 COMPONENT SIZES
SCALE: NONE

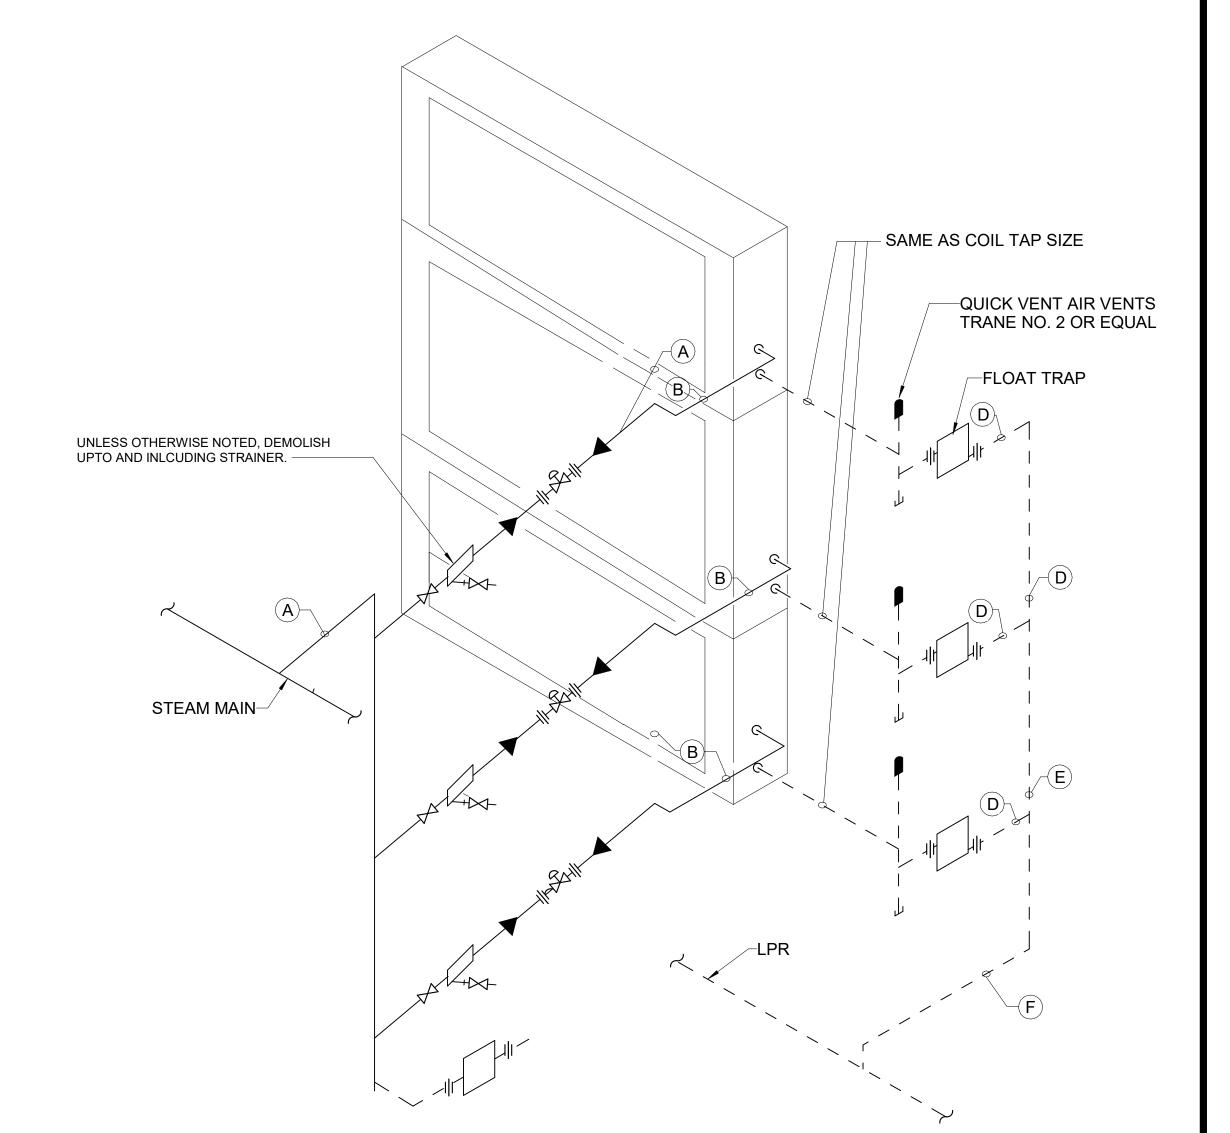

SYSTEM	A	B	<u>(C)</u>	D	E	F	SIZE	TRAP #/HR	NO.
H-5(1)	4"	2 1/2"	-	1 1/2"	-	2"	1"	281	2
(2)		2"	-	1 1/4"	-	1 1/2"	1 1/4"	395	2
H-6	6"	3"	4"	2"		3"	1 1/2"	1500	3
H-7(1)	6"	2 1/2"	3"	1 1/4"	2"	2"	1 1/4"	575	3
(2)		2 1/2"	3"	1 1/4"	2"	2"	1 1/4"	510	3
(3)		2"	3"	1 1/4"		2"	1 1/4"	460	3
H-8(1)	6"	2 1/2"	4"	1 1/2"	2"		1 1/4"	770	3
(2)		2 1/2"	3"	1 1/2"	2"	2"	1 1/4"	690	3
(3)		2 1/2"	3"	1 1/2"	2"	2"	1 1/4"	640	3
H-9(1)	6"	2 1/2"	-	1 1/2"	-	2"	1 1/4"	630	2
(2)		2 1/2"	-	1 1/4"	-	2"	1 1/4"	560	2
(3)		2"	-	1 1/4"	-	2"	1 1/4"	500	2

3 AIR HANDLER COIL COMPONENT SIZES
SCALE: NONE

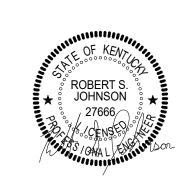

	REVISIONS	
NO:	DESCRIPTION:	DATE:
1	ADDENDUM #5	3/3/2023
2	ADDENDUM #8	3/20/2023

Facilities Management - Medical Center

H46 STEAM PIPING REPLACEMENT AS NOTED | BLDG. NAME: CHANDLER MEDICAL CENTER | DRAWN BY: MDF | PROJ. # 11130/XHSR22