



University of Kentucky[®]

Procurement Services

INVITATION FOR BIDS

CCK-3050.1-1-26

WT Young Library Renovation

PROJECT 3050.1

ADDENDUM #6

5/1/2026

IMPORTANT: BID AND ADDENDUM MUST BE RECEIVED BY 5/7/2026 @ 3:00 P.M. LEXINGTON, KY TIME

Bidder must acknowledge receipt of this and any addendum as stated in the Invitation for Bids.

ITEM #1: Extended Questions & Answers

- Refer to and incorporate within the offer, the enclosed additional information and Questions and Answers from the project team.

ITEM #2: Additional Drawings and Clarification.

- Please refer to the attached document for index and drawings

This will be the Final Addendum on this project, and no further questions will be addressed.

OFFICIAL APPROVAL
UNIVERSITY OF KENTUCKY

SIGNATURE

Contracting Officer / (859) 257-9102

Typed or Printed Name

CCK-3050.1
Extended Questions and Answers

<p>This wording is confusing and concerning for multiple reasons, and is the first mention of fully replacing the old units. Concerns include but are not limited to:</p> <ul style="list-style-type: none"> - If Base Bid only is accepted (in reference of Alt 5), of the 44 “to remain” VAVs/Reheats, would we actually need to include new control wiring and device mounting for all of these? Does that include a new control valve too? Some of these 44 “remaining” devices are in locations of the ground floor that aren’t even in the footprint of the renovated space and we would need access above ceiling/protection of finished surfaces in all surrounding areas... - Is Alternate #5 requesting the bidder to provide and install 44 additional new VAVs/reheat coils and install them in place of the existing 44 set to remain? As stated above, some of these are outside of the footprint of renovated area, and accessing them for new unit installation, hot water connections, and duct transitions is a significant undertaking, esp. in areas not covered with ceiling removal or surface protection in the main bid. The alternates have been confusing but this version is the first I am seeing that suggests we’re actively meant to replace existing units in areas of the building we aren’t even working in. - The actual HVAC Equipment Schedule sheet doesn’t provide new equipment selections for any of the existing “remaining” or “relocated” VAVs/Reheat coils. We MUST be given further information and models/selections if we are actually meant to price replacing those VAVs/reheats in any capacity. 	<p>Language has been clarified in Addendum 6 to list which VAV boxes are out of scope/the area of renovation - these out-of-scope VAV boxes will only need to be rebalanced at the end of the project.</p> <p>Information for selecting new VAV boxes to replace the old ones (max/minimum CFM and heating MBH) can be found in the VAV schedule on M-601 (sheet will not be reissued in Addendum 6 due to that information already being contained within the drawings and the new boxes having the same performance criteria as the boxes they're replacing).</p>
<p>IF you have a chance to include these two additional questions in the upcoming responses, please advise:</p> <ol style="list-style-type: none"> 1) Expansion loops for hydronic piping spec section 230516.00 references a requirement for delegated design on expansion loops and anchors. This project hydronic piping is just new branches on existing larger loops. Please confirm if this spec and a need for delegated design actually applies. 2) There are several new and relocated VAVs to be installed in the corridor to the right of the new GIS Classroom and are TECHNICALLY located in the shaded space covered by the first 90 days completion timeline, Phase 1. However, these VAVs and downstream duct flow to serve the large block of rooms to the right of the Phase 1 area, and do not SERVE the finished space of phase 1. (see below Phase 1 area highlighted yellow, with the VAV’s of concern circled in royal blue.) Is the intent that these blue-circled VAVs are ALL actually meant to be procured and installed above that corridor within the first 90 day timeframe?? Or it is understood that the rooms they serve and the corridor will remain accessible during Phase 2 (OR they are allowed to be installed above ceiling in adjacent offices/rooms rather than corridor, if corridor must be finished early). Please advise on the intent since they are RIGHT on the line. 	<ol style="list-style-type: none"> 1. This is still intended as delegated design - the delegated design professional would make the determination as to whether or not expansion loops are required 2. Intent as KLH understands it is that they're procured/installed as much as needs to be done to close out Phase 1, which would include procurement & install of the VAVs and any mains to limit work to the Phase 2 spaces after Phase 1 is complete.
<p>It appears UK will be providing the DDC controllers.</p> <p>Can you please confirm what Manufacture and controller model UK will be using?</p> <p>We will need this to quote the thermostat / sensors.</p>	<p>UK is furnishing Distech ECB-VAV controllers for the project.</p>

<p>27 41 00.00 - Audio and Video System / 27 41 01.00 - Audio and Video System</p> <p>The Plans and Specifications are based on UK AV Standards for Single Projection Classrooms, Dual Projection Classrooms, and Collaboration Space Level 3, but neither the plan nor the specifications show these standards in their entirety. The Classroom systems in the plans and specifications do not show the following items per the UK AV Standard for these spaces:</p> <p>Networking Cisco Switch (typically owner furnished) located in the AV Rack and required accessories from the standard -Correct, UK will provide the network switch. If the Network Switch is to be mounted in the AV Equipment Rack, is it to be Owner or Contractor Furnished</p> <p>Power and Protection Rack Mount power for AV and Networking with required accessories from the standard Middle Atlantic ERK-2128 Series Rack with required accessories from the standard</p> <p>Furniture Lectern Will the lectern be the same found in the UK Classroom AV Standard -Yes Is the Classroom Lectern to be provided by the AV Contractor, Furniture Contractor, or Owner -AV contractor Etc</p>	<p>No sound masking required.</p> <p>Plans updated to include equipment lists. Intent to adhere to UK standards as close as possible. Lectern is to be provided by AV contractor.</p>
<p>There is a General Note on T-641 that makes reference to the UK AV Standards, but only one Detail on this sheet is per the standard. Is the intent of this bid package to conform to the UK AV Standard in its entirety, or only as depicted in the Plans and Specifications? – The intention is to conform to UK AV standards. The drawings were intended to indicate which standard was to be applied to each space with some specific exceptions.</p>	<p>Deviations from UK standards have been better defined. Intent to adhere to UK standards as close as possible.</p>
<p>T-100A - Group Room B66 shows a Collaboration System Level 3, where is the Touch Screen to be located for this system – Wall mount adjacent to plan north door.</p>	<p>Wall mount adjacent to plan north door.</p>
<p>T-100B - Multifunction Room B108D shows an AV System with three projection screens with Keyed Note to add additional Projector and Screen. Does the size of the Extron DTP3 Crosspoint 622 need to be increased to allow for an additional Matrixed Output or will this projector use a mirrored output from the existing DTP3 Crosspoint 622.</p>	<p>This projector use a mirrored output from the existing DTP3 Crosspoint 622.</p>
<p>T-100D - Work Room B23 Appears to have an AV System, but only shows a single display - is a single display all that is required or is there a system type that applies to this room.</p>	<p>This is to be a collaboration space level 2.</p>
<p>On Door Hardware Specs – 087100, Hardware Set# (CE01, CE01A, CE02, and E01) calls for a RX-LX-QEL-55NL-OP Panic Device. The 55 series Panic Device does not have the LX or QEL options. Could you please verify if we can quote this as 33A (Grooved) or 35A (Smooth) narrow stile exit device instead? As the 33/35 series has the options for RX, LX, and QEL.</p>	<p>No, the 55 series is necessary for this door type. The LX and QEL options can be omitted.</p>
<p>On Door Hardware Specs – 087100, Openings (B18A and B102) is on the specs, but does not exist on the Door Schedule or Floor Plans. Could you please verify if these openings exist? If so, could you please provide what type of openings they are or are we only providing hardware for these openings?</p>	<p>Doors are not in scope</p>
<p>On Door Schedule A-601, Opening (B68) does not have Frame Material or Frame Type marked. Could you please verify what Frame Material and Frame Type this opening needs?</p>	<p>HM</p>
<p>On Door Schedule A-601, Openings (B23, B28A, B28B, B29, and B66) do not have HW Set #. Could you please verify what HW Set #'s these openings should be?</p>	<p>B23 C01C, B28A CE01A, B28B CE01A, B29 C01E, and B66 C01C</p>
<p>On Door Schedule A-601, All openings do not have assigned Frame Type's. Could you please verify what Frame Type's each opening should be?</p>	<p>All are frame type 1, unless noted otherwise</p>

FOR THE PROJECT TITLED:

**WT YOUNG LIBRARY
LOWER LEVEL RENOVATION**

University of Kentucky
Lexington, Kentucky

To: Prospective Bidders

From: JRA Architects
301 East Vine Street
Lexington, Kentucky 40507

Project Contact: P. Matthew DeLuca, AIA

The Addendum will form a part of the Contract Documents and modifies the original Bidding Documents dated April, 2026.

Bidders must acknowledge receipt of this Addendum in the space provided on the Form of Proposal. Failure to do so may subject the bidder to disqualification.

Bidding Documents, including the Drawings and Specifications, are amended as described herein.

ARCHITECTURAL ITEMS:

ITEM NO. 6.01

- Refer to reissued sheet A-422 attached. Dimensions were added to the existing window openings to clarify the extent and widths of the window film on the first row of glass.

ITEM NO. 6.02

- Refer to reissued sheet A-601 attached. Door type FG was revised to show only 60" coverage of window film in lieu of full glass coverage.

ITEM NO. 6.03

- Refer to reissued sheet A-621 attached. The finish material schedule was updated to note the Basis-of-Design product for WT-2, the wall tile at the break room backsplash.

CONTROLS ITEMS

ITEM NO. 6.04

- Sheet IC-001 - Mechanical - Controls Sheet
 - a) Added Make/Model of UK-furnished VAV controller.

ITEM NO. 6.05

- Sheet M-001 - Mechanical Cover Sheet
 - a) Updated "HVAC Alternates" block to address some field questions regarding out-of-scope boxes and questions on selecting new equipment to replace existing.

TECHNOLOGY ITEMS:

ITEM NO. 6.06

- Sheet T-100A - Technology Basement Plan Area A
 - a) Added control panel location.

ITEM NO. 6.07

- Sheet T-100B - Technology Basement Plan Area B
 - a) Revised note.

ITEM NO. 6.08

- Sheet T-641 - Technology Av Systems
 - a) Revised Collaboration Space Level 3

ITEM NO. 6.09

- Sheet T-642 - Technology Av Systems
 - a) Revised single projector classroom.
 - b) Added requirements for Collaboration Space levels 1 & 2.



ITEM NO. 6.10

- Sheet T-643 - Technology Av Systems
 - a) Revised dual projector classroom.

END OF ADDENDUM NO. 6.00

C:\Users\mducal\JRA\Projects\UK WT Young Library - Lower Level Renovation\Revit\Autocad\Revit\2025\Collaboration\Chgs\CHG\KEYNOTE\KEYNOTE.dwg (11/14/2025 10:56:56 AM) 11/14/2025 10:56:56 AM

NO.	PAIR	DOORS						FRAMES				HARDWARE			REMARKS	
		SIZE		HEIGHT	THICK.	MAT'L.	TYPE	GLAZ.	MAT'L.	TYPE	DETAILS		CLOSER	SET NO.		RATING (MIN.)
		LEAF 1 WIDTH	LEAF 2 WIDTH								JAMB	HEAD				
B23		3'-0"		9'-2"	1 3/4"	WD.	FG	GL-2	ALUM.	SEE DTL.	SEE DTL.	--	--	--	0	
B25		3'-0"		9'-0"	1 3/4"	WD.	F		ALUM.	SEE DTL.	SEE DTL.	--	--	--	0	
B26A		3'-0"		7'-10"	1 3/4"	WD.	FG	GL-2	HM.	102	202	--	--	--	0	2
B26B		3'-0"		7'-10"	1 3/4"	WD.	FG	GL-2	HM.	102	202	--	--	--	0	2
B26C		3'-0"		7'-10"	1 3/4"	WD.	FG	GL-2	HM.	102	202	--	--	--	0	2
B26D		3'-0"		7'-10"	1 3/4"	WD.	FG	GL-2	HM.	102	202	--	--	--	0	2
B26E		3'-0"		7'-10"	1 3/4"	WD.	FG	GL-2	HM.	102	202	--	--	--	0	2
B26F		3'-0"		7'-10"	1 3/4"	WD.	FG	GL-2	HM.	102	202	--	--	--	0	2
B26G		3'-0"		7'-10"	1 3/4"	WD.	FG	GL-2	HM.	102	202	--	--	--	0	2
B26H		3'-0"		7'-10"	1 3/4"	WD.	FG	GL-2	HM.	102	202	--	--	--	0	2
B27		3'-0"		7'-10"	1 3/4"	WD.	F		HM.	102	202	--	--	--	0	2
B28A		3'-0"		9'-2"	1 3/4"	WD.	FG	GL-2	ALUM.	SEE DTL.	SEE DTL.	--	--	--	0	
B28B		3'-0"		9'-2"	1 3/4"	WD.	FG	GL-2	ALUM.	SEE DTL.	SEE DTL.	--	--	--	0	
B29		3'-0"		7'-10"	1 3/4"	HM.	F		HM.	102	202	--	--	--	0	2
B33		3'-0"		7'-10"	1 3/4"	HM.	F		HM.	102	202	--	--	--	0	2
B35A		3'-0"		7'-10"	1 3/4"	WD.	FG	GL-2	HM.	102	202	--	--	--	0	2
B35B		3'-0"		7'-10"	1 3/4"	WD.	FG	GL-2	HM.	102	202	--	--	--	0	2
B35C		3'-0"		7'-10"	1 3/4"	WD.	FG	GL-2	HM.	102	202	--	--	--	0	2
B108A-A				9'-2"	1 3/4"	WD.	M1	GL-2	ALUM.	SEE DTL.	SEE DTL.	--	--	--	0	1
B108A-B				8'-2"	1 25/32"											4
B108B-A				109/256"												
B108B-B				7'-10"	1 3/4"	WD.	F		HM.	102	202	--	--	--	0	
B108C-A				7'-10"	1 3/4"	WD.	F		HM.	102	202	--	--	--	0	
B108C-B				7'-10"	1 3/4"	WD.	F		HM.	102	202	--	--	--	0	
B108D-A				7'-10"	1 3/4"	WD.	F		HM.	102	202	--	--	--	0	
B109				9'-2"	1 3/4"	WD.	M1	GL-2	ALUM.	SEE DTL.	SEE DTL.	--	--	--	0	
B110A				9'-2"	1 3/4"	WD.	M1	GL-2	ALUM.	SEE DTL.	SEE DTL.	--	--	--	0	1
B110-B				8'-2"	1 25/32"											4
				109/256"												

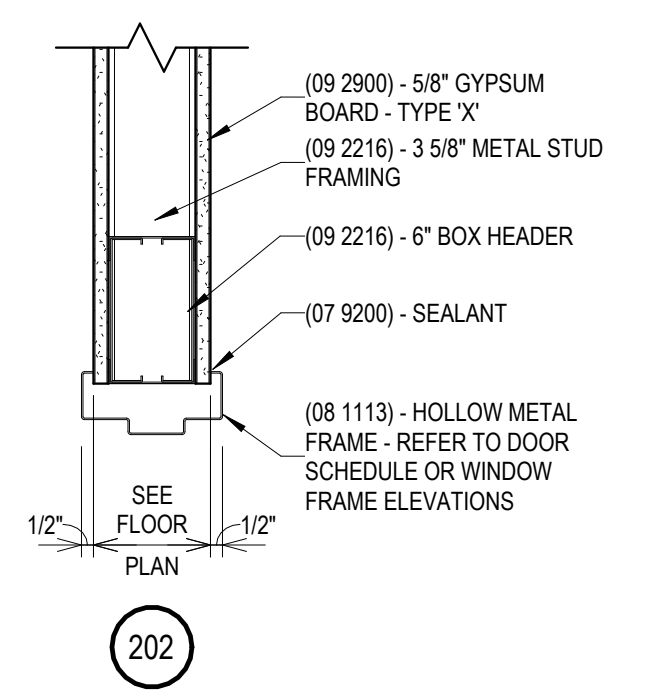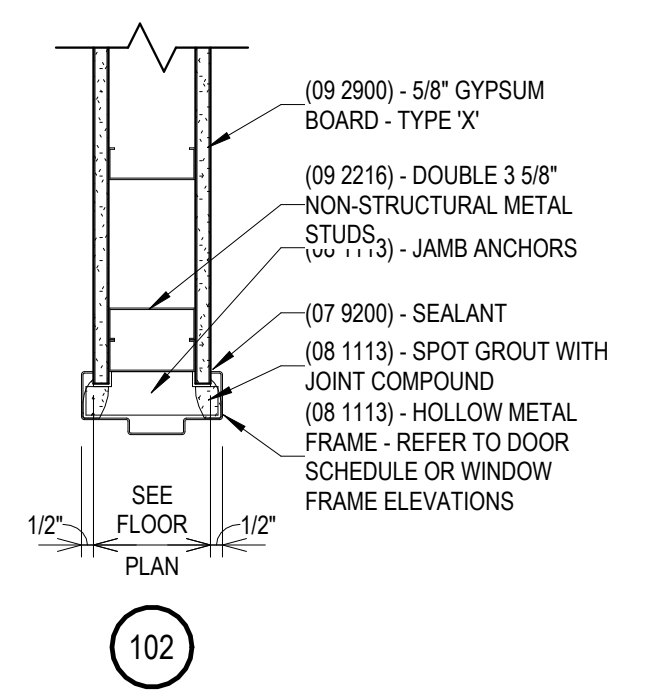

C DOOR DETAILS
1 1/2" = 1'-0"


DOOR AND FRAME SCHEDULE KEYED REMARKS

- REFER TO ALTERNATE #1
- APPLY FULL COVERAGE WINDOW FILM TO GLAZING - CORRIDOR ROOM FACE
- PROVIDE RIM AND MORTISE CYLINDERS AS REQUIRED FOR EXIT DEVICES - KEYED TO MASTER
- SPECIALTY FOLDING DOORS - REFER TO ALTERNATE #1 AND SPECIFICATION 08 2513
- PROVIDE KEY PAD - SEE ELECTRICAL


TABLE 716.3 MARKING FIRE-RATED GLAZING ASSEMBLIES		
FIRE TEST STANDARD	MARKING	DEFINITION OF MARKING
ASTM E 119 OR UL 263	W	MEETS WALL ASSEMBLY CRITERIA
NFPA 252 OR UL 9	OH	MEETS FIRE WINDOW ASSEMBLY CRITERIA INCLUDING HOSE STREAM TEST.
NFPA 252 OR UL 10B OR UL 10C	D	MEETS FIRE DOOR ASSEMBLY CRITERIA
NFPA 252 OR UL 10B OR UL 10C	H	MEETS FIRE DOOR ASSEMBLY "HOSE STREAM" TEST.
NFPA 252 OR UL 10B OR UL 10C	T	MEETS 450°F TEMPERATURE RISE CRITERIA FOR 30 MINUTES.
NFPA 252 OR UL 10B OR UL 10C	XXX	THE TIME IN MINUTES OF THE FIRE RESISTANCE OR FIRE PROTECTION RATING OF THE GLAZING ASSEMBLY.

KEYNOTE LEGEND	
KEY VALUE	KEYNOTE DESCRIPTION
07 9200.A2	(07 9200) - SEALANT
08 1113.A2	(08 1113) - HOLLOW METAL FRAME - REFER TO DOOR SCHEDULE OR WINDOW FRAME ELEVATIONS
08 1113.B1	(08 1113) - JAMB ANCHORS
08 1113.C2	(08 1113) - SPOT GROUT WITH JOINT COMPOUND
09 2216.C1	(09 2216) - 3/8\"/>


GLAZING SCHEDULE	
MARK	TYPE
GL-1	1/4\"/>

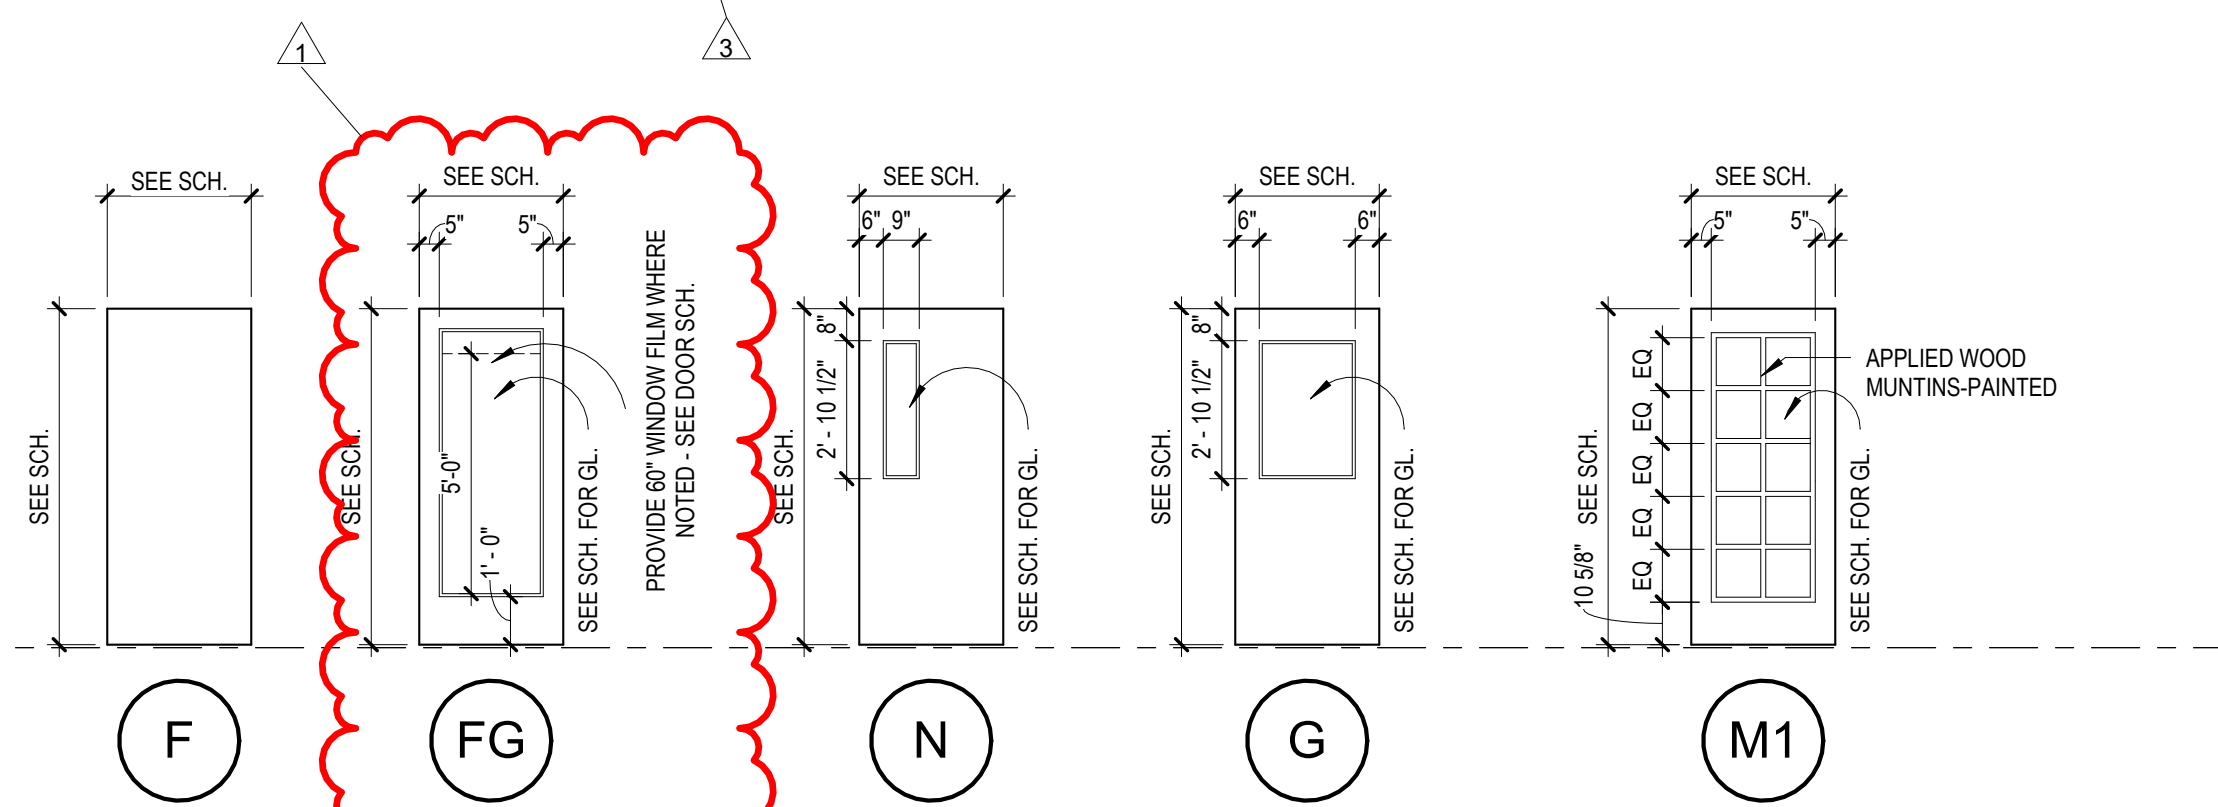

A DOOR TYPES
1/4" = 1'-0"

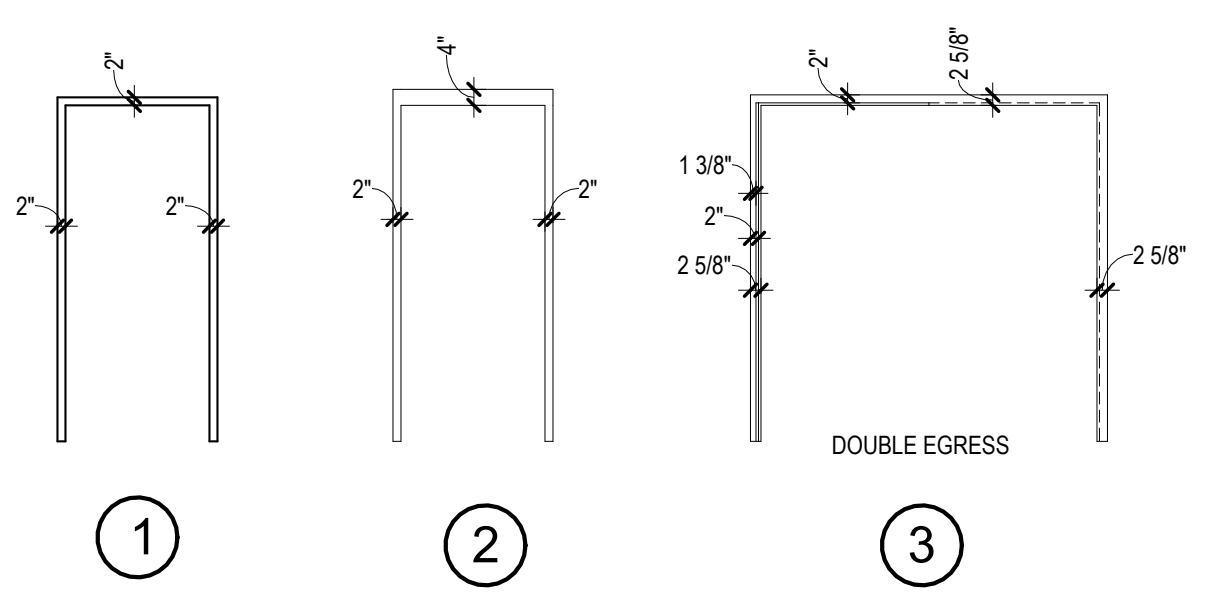


B DOOR FRAME TYPES
1/4" = 1'-0"

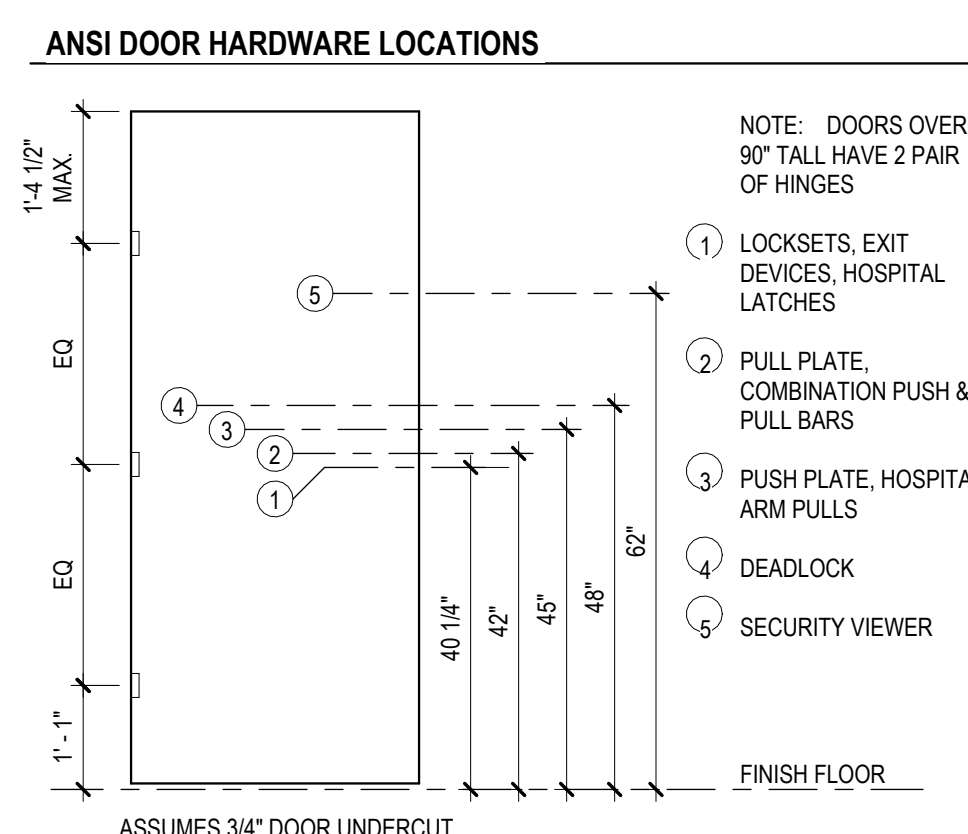

- GENERAL NOTE**
- REFER TO WALL SECTIONS & INTERIOR PARTITION TYPES FOR ADDITIONAL NOTES REGARDING TYPICAL WALL CONSTRUCTION.
 - HANDING AS INDICATED ON PLANS.
 - PROVIDE LEAD LINED HOLLOW METAL FRAMES IN THICKNESS EQUIVALENCY AS INDICATED ON THE FLOOR PLANS.

DOOR CLOSER LOCATIONS - UNLESS OTHERWISE NOTED

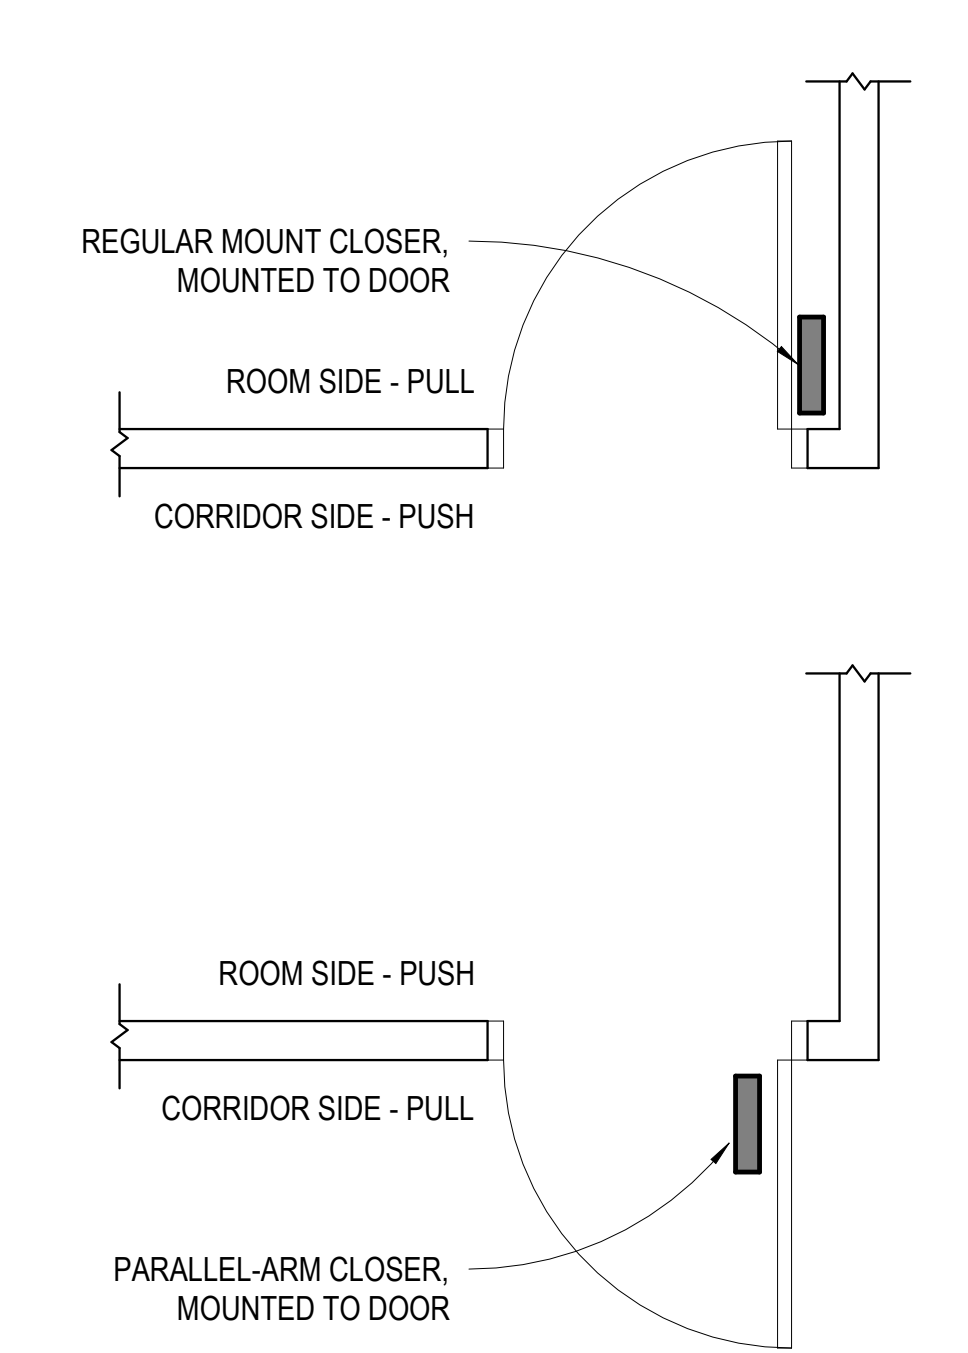

301 East Vine Street
Lexington, Kentucky 40507
859.252.6781



RESERVED FOR ANJ STAMP


BID DOCUMENTS
UK WT YOUNG LIBRARY - LOWER LEVEL RENOVATION
UNIVERSITY OF KENTUCKY
LEXINGTON, KENTUCKY

ARCHITECTURAL		
PROJECT	202586	
DATE	03.31.2026	
REVISIONS		
No.	Description	Date
1	ADDENDUM 6	4/30/2026
3	ADDENDUM 3	4/18/2026

JRA ARCHITECTS HAS RETAINED AN ELECTRONIC VERSION OF THESE DRAWINGS. THE CLIENT AGREES NOT TO REUSE THESE DRAWINGS IN ELECTRONIC OR ANY OTHER FORMAT IN WHOLE OR IN PART FOR ANY PURPOSE OTHER THAN FOR THE PROJECT. THE CLIENT AGREES NOT TO TRANSFER THESE ELECTRONIC FILES TO OTHERS WITHOUT THE PRIOR WRITTEN CONSENT OF THE ARCHITECT. THE CLIENT FURTHER AGREES TO WAIVE ALL CLAIMS AGAINST THE ARCHITECT RESULTING IN ANY WAY FROM ANY UNAUTHORIZED CHANGES TO OR REUSE OF THE ELECTRONIC FILES FOR ANY OTHER PROJECT BY ANYONE OTHER THAN THE ARCHITECT.

DOOR SCHEDULE AND DETAILS



A-601
COPYRIGHT 2026 - JRA, INC.

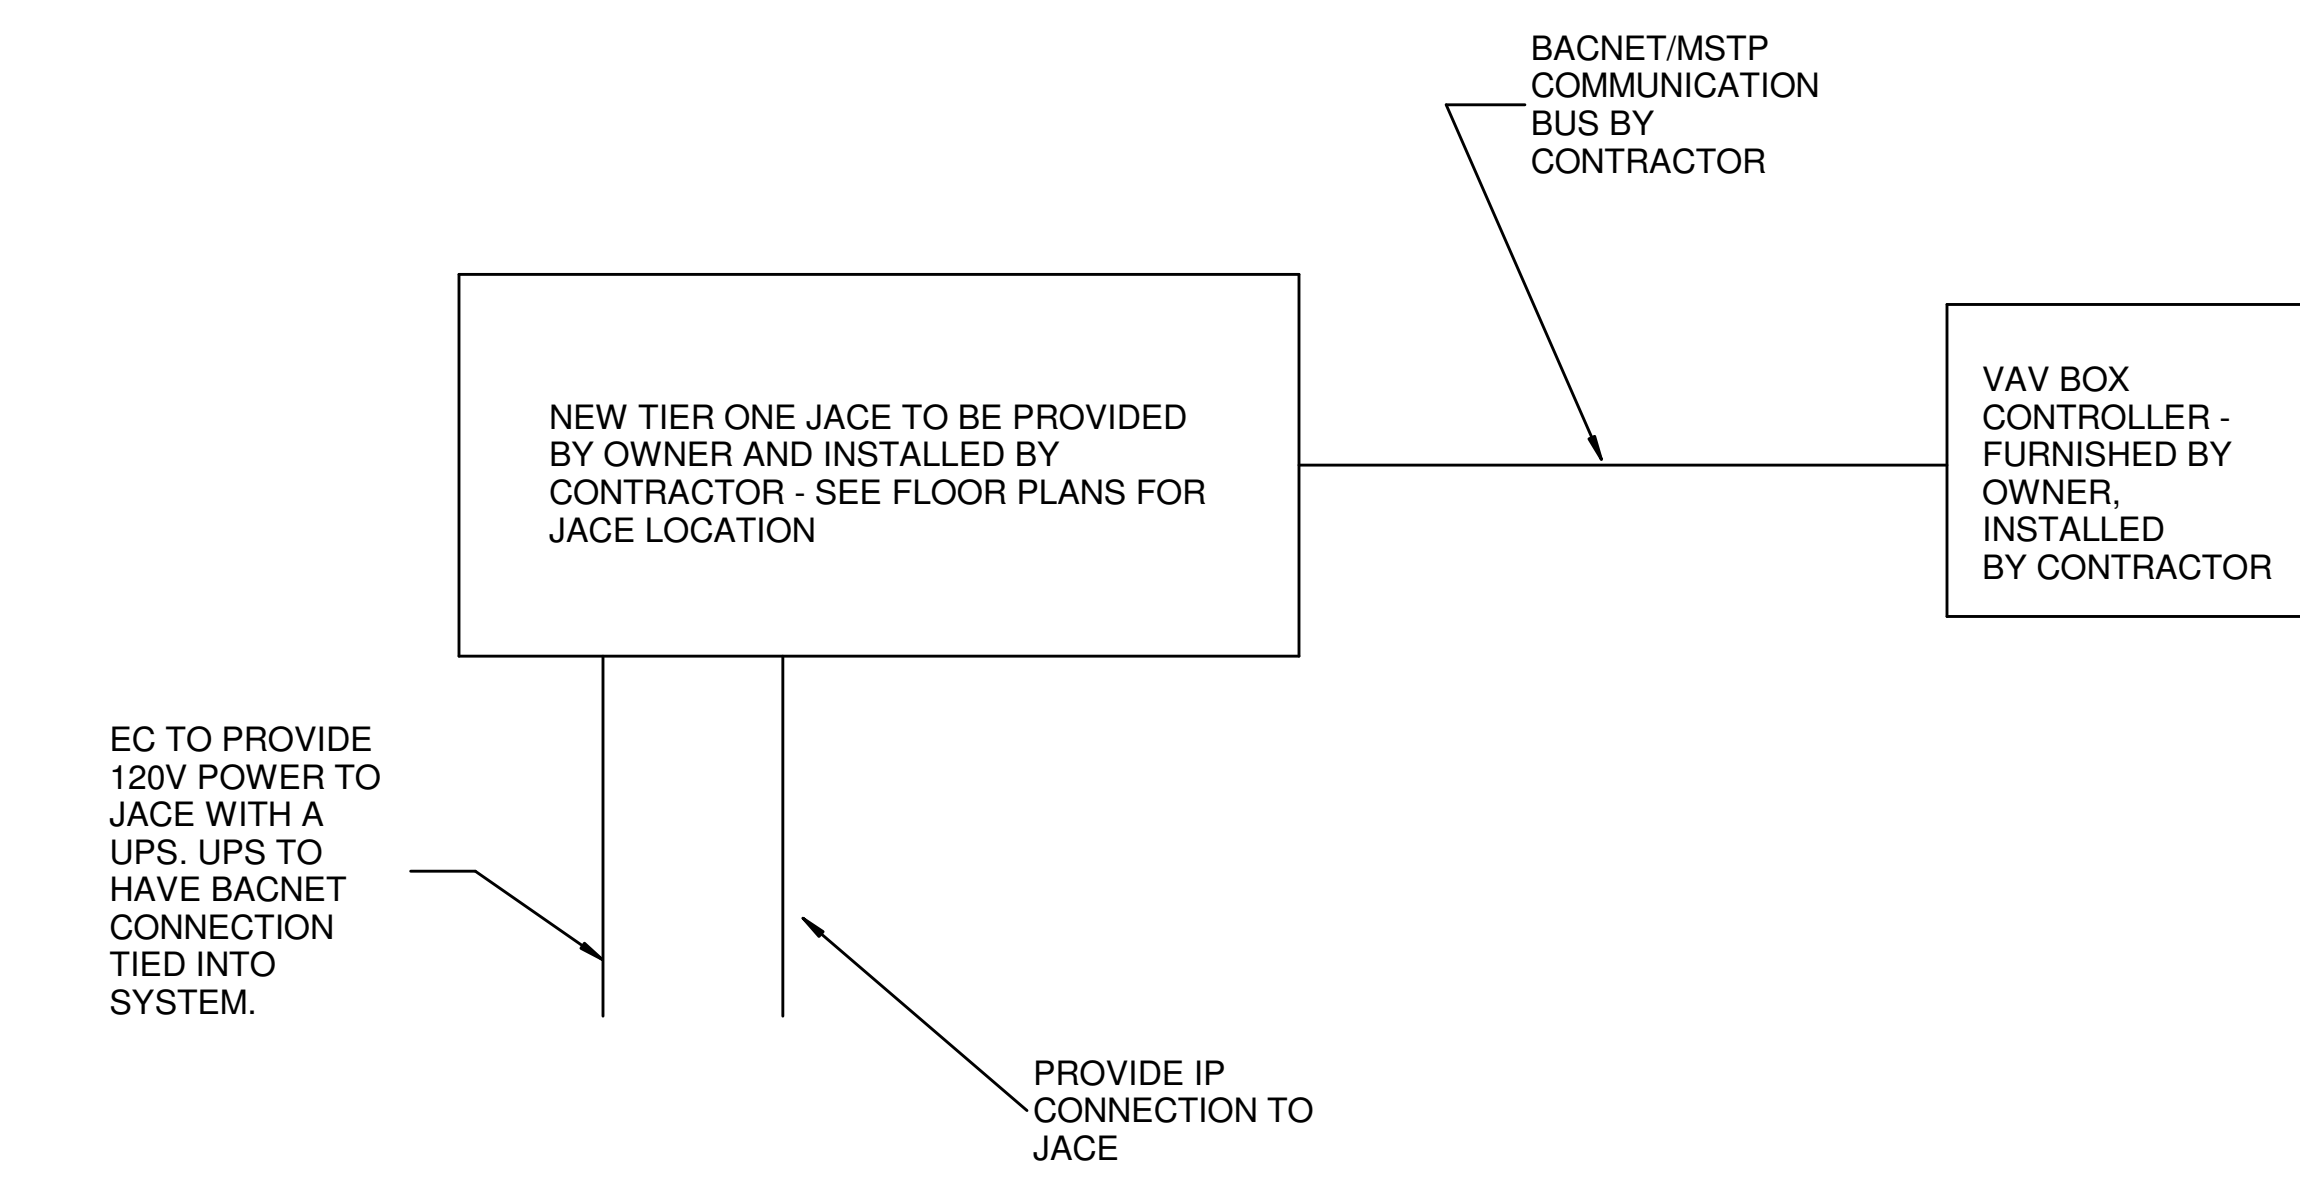

DESCRIPTION	ELEC CONTR	MECH CONTR	CONT CONTR	COMM CONTR	UK
VAV BOXES		X			
FURNISH AND PROGRAM VAV CONTROLLERS					X
PROVIDE AND INSTALL WIRE AND PROGRAM ALL THERMOSTATS, ALL SENSORS. INSTALL OWNER-FURNISHED VAV CONTROLLERS. ALL DEVICES SHALL HAVE BACNET/MSTP CONNECTIONS.			X		
INTEGRATION, TRENDRING, GRAPHICS					X
PROVIDE INSTALL AND WIRE 120V/1 JUNCTION BOXES	X				
PROVIDE, INSTALL AND WIRE LOW VOLTAGE TRANSFORMERS (INCLUDES TRANSFORMERS FOR RELOCATED EQUIPMENT)	X				
PROVIDE & INSTALL UPS FOR OWNER-FURNISHED CONTRACTOR-INSTALLED JACE			X		
PROVIDE AND INSTALL BACK BOXES, CONDUITS, PATHWAYS FOR ALL CONTROLS			X		
NETWORK DROP				X	
COMMISSIONING	X	X			X

NOTES:
ELEC CONTR SHALL COORDINATE SCOPE WITH MECH CONTR

UK FURNISHED VAV CONTROLLER, DISTECH ECB-VAV CONTROLLER.

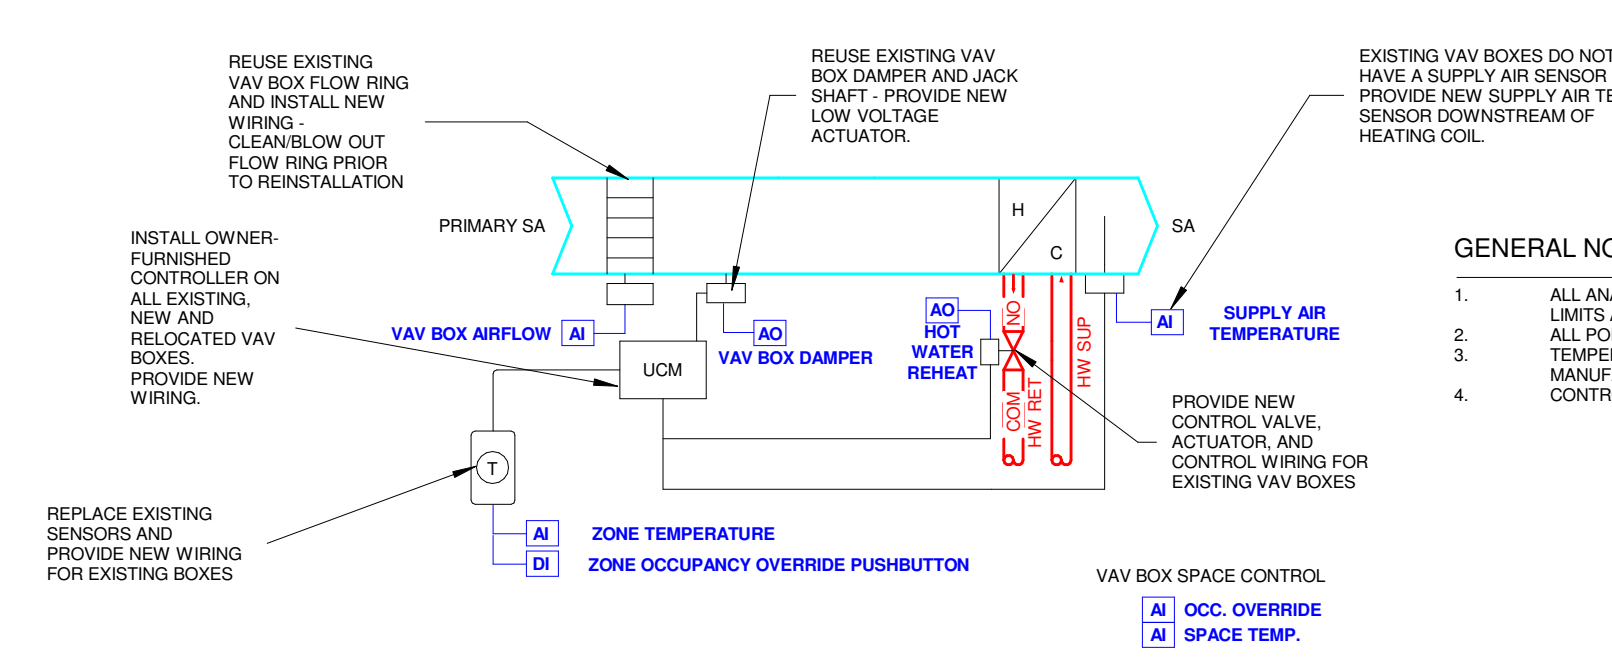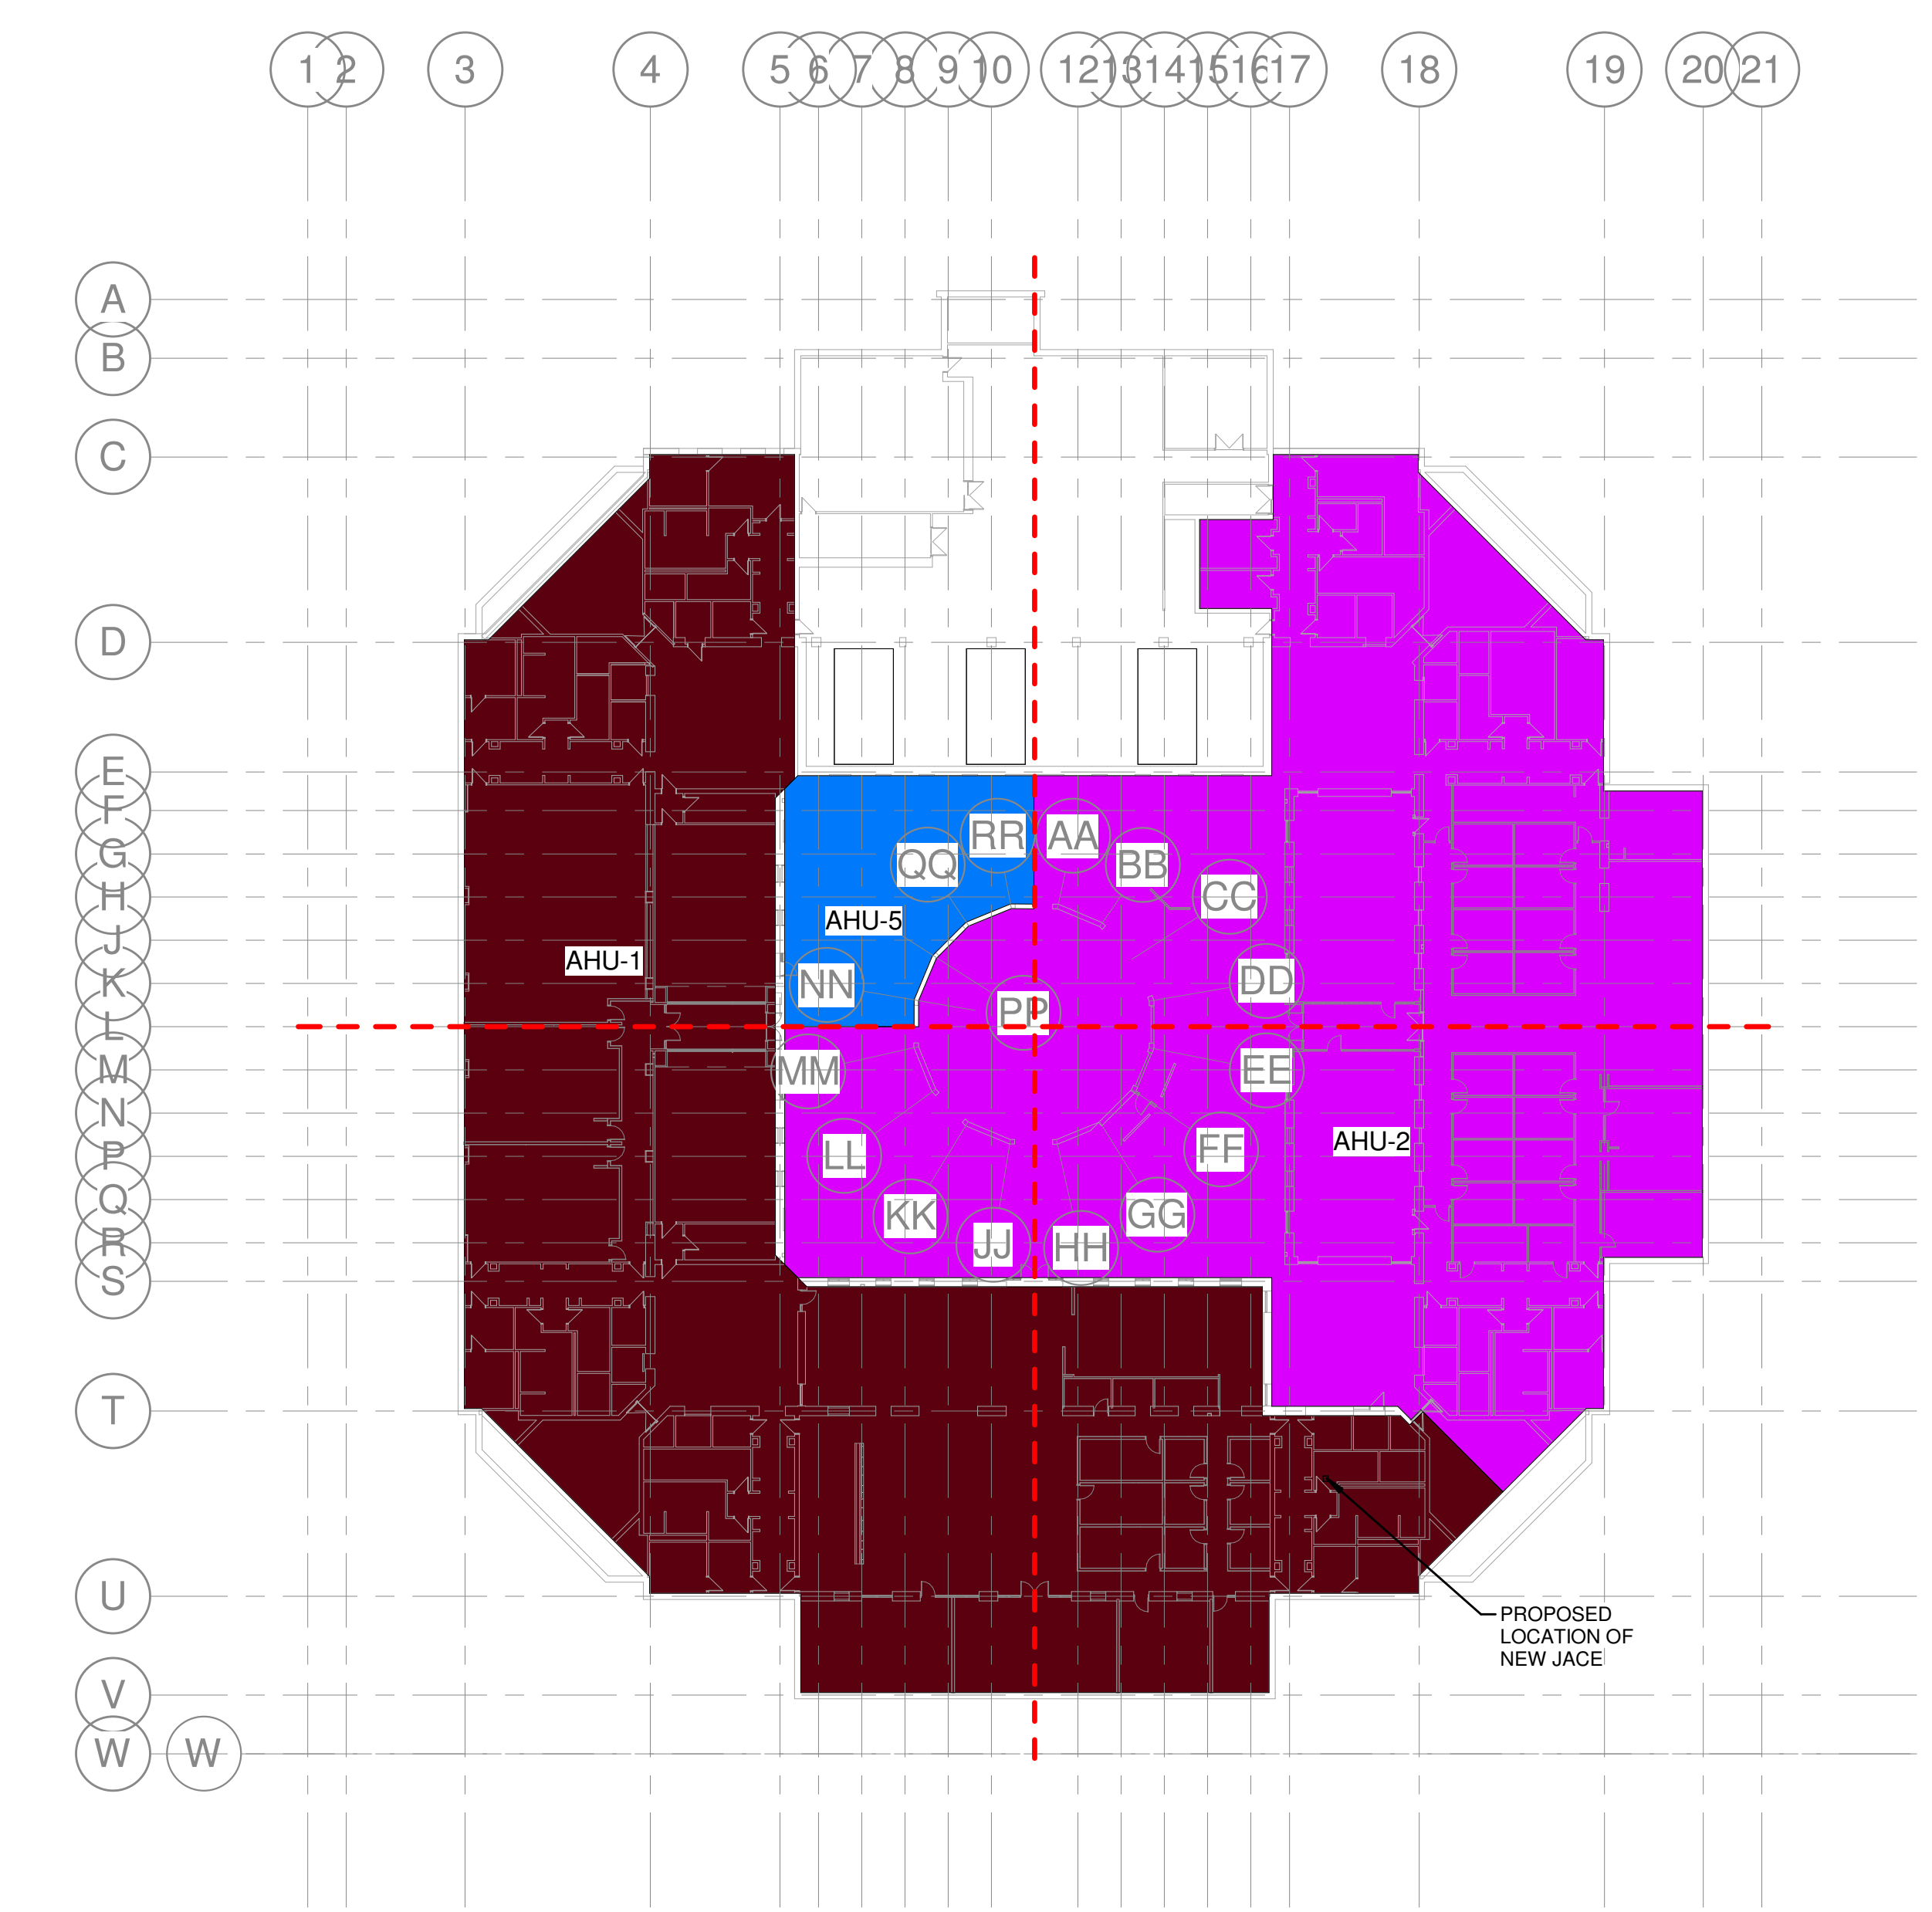

- SEQUENCE OF OPERATIONS**
For new VAV boxes provide all-new controls and install owner-furnished controller.
- For existing VAV boxes that are being reused in the scope of work, install new owner-provided controller and provide and install thermostat and control wiring. Some components of existing VAV boxes are being reused - see notes above for what items are being reused and what items need to be replaced or provided if not currently existing, and see alternates for additional information.
- A. VAV Boxes w/Hot Water Reheat
- Provide two-way, fail open, modulating control valve for hot water coils on all new and existing boxes within the scope of work.
 - Install owner-furnished low voltage DDC controller, differential pressure transmitter, actuator and wiring for VAV boxes. Temperature Controls Contractor shall field or factory mount controller at their expense. VAV box manufacturer shall furnish flow ring, 1/2" round damper shaft for direct mounting of actuator, and control enclosure. Temperature Controls Contractor shall provide transformers with connection to line voltage junction box above ceiling provided by electrical contractor in various locations. Provide room temperature sensor(s) with room temperature setpoint adjustment capability +/- 3 deg. F., adjustable thru BAS) and override feature (2 hours, adjustable thru BAS). On a call for heat, VAV damper shall modulate down to minimum setpoint position. On a further call for heating, control valve shall open and modulate to maintain space temperature. On a call for cooling, control valve shall close and damper shall modulate open to satisfy room temperature. Provide supply air temperature sensor tied to BAS.
 - Control and monitoring points shall include but not be limited to the following:
 - Reheat valve command (AO)
 - Damper command (AO)
 - Zone space temperature (AI)
 - Zone occupancy temperature override (AI)
 - Actual CFM (AI)
 - Discharge air temperature (AI)
 - Occupancy status (DI)

- GENERAL NOTES:**
- ALL ANALOG INPUTS (AI) SHALL BE CONFIGURED BY USER FOR HIGH AND LOW LIMITS ALTERN.
 - ALL POINTS SHALL BE TRENDED AND HAVE RUN TIME TOTALIZATION.
 - TEMPERATURE CONTROL CONTRACTOR IS RESPONSIBLE FOR COORDINATING WITH MANUFACTURER AND PROVIDE POINTS AS NOTED.
 - CONTROLLER MUST BE BACNET/MP.

1 23T-033 - SINGLE DUCT VAV BOX W/ HOT WATER REHEAT
1/8" = 1'-0"

MECHANICAL

PROJECT	202586
DATE	03.31.2026

REVISIONS		
No.	Description	Date
1	ADDENDUM 3	04/16/26
2	ADDENDUM 4	04/21/26
3	ADDENDUM 6	05/01/26

JRA ARCHITECTS HAS RETAINED AN ELECTRONIC VERSION OF THESE DRAWINGS. THE CLIENT AGREES NOT TO REUSE THESE DRAWINGS IN ELECTRONIC OR ANY OTHER FORMAT IN WHOLE OR IN PART FOR ANY PURPOSE OTHER THAN FOR THE PROJECT. THE CLIENT AGREES NOT TO TRANSFER THESE ELECTRONIC FILES TO OTHERS WITHOUT THE PRIOR WRITTEN CONSENT OF THE ARCHITECT. THE CLIENT FURTHER AGREES TO WAIVE ALL CLAIMS AGAINST THE ARCHITECT RESULTING IN ANY WAY FROM ANY UNAUTHORIZED CHANGES TO OR REUSE OF THE ELECTRONIC FILES FOR ANY OTHER PROJECT BY ANYONE OTHER THAN THE ARCHITECT.

MECHANICAL - CONTROLS SHEET

MECHANICAL LEGEND	
SYMBOL	DESCRIPTION
PLAN-VIEW LINE TYPES	
	WORK SHOWN FADED INDICATES EXISTING WORK TO REMAIN OR NEW WORK BY OTHERS AS APPLICABLE
	WORK SHOWN BOLD-DASHED INDICATES SELECTIVE DEMOLITION WORK
	WORK SHOWN BOLD-CONTINUOUS INDICATES NEW WORK
DRAWING SET APPEARANCE	
TO BETTER COMMUNICATE SCOPE TO PERMIT AGENCIES AND CONTRACTORS, EACH DRAWING IN THIS DRAWING SET HAS BEEN CREATED IN BOTH "COLOR" AND "BLACK AND WHITE". THERE EXISTS A COLOR LAYER WITHIN EACH DRAWING WHERE VISIBILITY IS CONTROLLED THROUGH THE PDF LAYER MANAGER. THIS LAYER VISIBILITY CAN BE TOGGLED DISPLAYING EITHER "COLOR" OR "BLACK AND WHITE". TO MAINTAIN SCOPE BASED SHADING WHEN PRINTING TO PAPER, BLACK AND WHITE NEEDS TO BE VISIBLE. FOR FURTHER INSTRUCTIONS, REFER TO CONTRACTOR RESOURCES ON OUR WEBSITE AND DOWNLOAD "DRAWING COLOR INSTRUCTIONS". WWW.KLHENGRS.COM - CONTRACTOR RESOURCES (RIGHT HAND SIDE OF PAGE).	
PIPING LINE TYPES	
	HWS - HOT WATER SUPPLY
	HWR - HOT WATER RETURN
	LPS - LOW PRESSURE STEAM
	LPC - LOW PRESSURE STEAM CONDENSATE
MECHANICAL PIPING ACCESSORIES	
	MANUAL ISOLATION VALVE
	AUTOMATIC BALANCING VALVE
	MANUAL BALANCING VALVE
	UNION
	TEMPERATURE & PRESSURE TEST PORT
	FLOW DIRECTION
	FLEX PIPING CONNECTOR
	Y-STRAINER
	STRAINER WITH BLOW OFF
	DRAIN VALVE (3/4" UNLESS OTHERWISE NOTED)
	MANUAL AIR VENT
	2 WAY CONTROL VALVE (MODULATING)

MECHANICAL LEGEND	
SYMBOL	DESCRIPTION
MECHANICAL AIR DEVICES	
	SUPPLY REGISTER
	RETURN GRILLE
	CEILING DIFFUSER
	2x2' SQUARE CEILING DIFFUSER WITH 10" NECK
	LINEAR SLOT DIFFUSER
MECHANICAL DUCTWORK	
	SUPPLY DUCT
	RETURN DUCT
	EXHAUST DUCT
	OUTSIDE AIR DUCT
	1" LINED DUCTWORK
	DUCT FLEX CONNECTOR
	FLEXIBLE DUCTWORK CONNECTION
	BRANCH TAKEOFF
	REDUCER, CONCENTRIC
	REDUCER, NONCONCENTRIC
MECHANICAL DUCTWORK ACCESSORIES	
	DUCT WITH MANUAL VOLUME DAMPER
	ELBOW WITH TURNING VANES

MECHANICAL LEGEND	
SYMBOL	DESCRIPTION
MECHANICAL STATS & SENSORS	
	LOW VOLTAGE THERMOSTAT
MECHANICAL MISCELLANEOUS	
	DIGITAL INPUT
	DIGITAL OUTPUT
	ANALOG INPUT
	ANALOG OUTPUT
	HARD WIRE INTERLOCK
	CONNECT TO EXISTING (FIELD VERIFY EXISTING UTILITY SERVICE TYPE, PRIOR TO MAKING CONNECTION)

HVAC ALTERNATES

ALTERNATE NO. 4: RELOCATED VAV BOXES

BASE BID: REFER TO THE MECHANICAL DRAWINGS. THE 23 EXISTING HOT WATER VAV BOXES TO BE RELOCATED TO RECEIVE CONTROLS UPGRADES (OLD DDC STANDARD TO NEW DDC STANDARD) IN THE BASE BID. CONTROLLERS ARE OWNER-FURNISHED, CONTRACTOR-INSTALLED.

ALTERNATE BID: THE 23 EXISTING VAV BOXES TO BE RELOCATED WILL BE REPLACED WITH NEW CONTROLLERS ARE OWNER-FURNISHED, CONTRACTOR-INSTALLED.

REFER TO M601 FOR MAXIMUM AND MINIMUM AIRFLOWS ALONG WITH HEATING MBH TO ALLOW FOR SELECTION OF NEW EQUIPMENT TO MATCH THE PERFORMANCE OF EXISTING. REFER TO NEW VAVS WITHIN THAT SAME SCHEDULE FOR VAV BASIS OF DESIGN.

ALTERNATE NO. 5: VAV BOXES TO REMAIN

BASE BID: REFER TO THE MECHANICAL DRAWINGS. EXISTING HOT WATER VAV BOXES TO REMAIN IN PLACE TO RECEIVE CONTROLS UPGRADES (OLD DDC STANDARD TO NEW DDC STANDARD) IN THE BASE BID. CONTROLLERS ARE OWNER-FURNISHED, CONTRACTOR-INSTALLED.

ALTERNATE BID: THE 44 EXISTING VAV BOXES TO REMAIN IN PLACE WILL BE REPLACED WITH NEW CONTROLLERS ARE OWNER-FURNISHED, CONTRACTOR-INSTALLED.

REFER TO M601 FOR MAXIMUM AND MINIMUM AIRFLOWS ALONG WITH HEATING MBH TO ALLOW FOR SELECTION OF NEW EQUIPMENT TO MATCH THE PERFORMANCE OF EXISTING. REFER TO NEW VAVS WITHIN THAT SAME SCHEDULE FOR VAV BASIS OF DESIGN.

COMMON TO THESE ALTERNATES:

NEW CONTROL VALVES, NEW ACTUATORS, AND NEW CONTROL WIRING TO BE PROVIDED FOR ALL EXISTING TO-REMAIN AND RELOCATED VAVS.

THERE ARE (9) VAV BOXES (V1-B97, V1-B-E92, V1-B-117, V1-B-E11, V2-B-E11, V2-B-E12, V2-B-114, V2-E99, AND V1-B444) THAT ARE EXISTING TO-REMAIN AND SERVE OUT-OF-SCOPE AREAS. THESE BOXES WILL NOT RECEIVE CONTROLS VALVES/ACTUATORS - ONLY SCOPE FOR THESE BOXES IS PRE-CONSTRUCTION BALANCING AND THEN RE-BALANCING TO PRE-CONSTRUCTION AIR/WATER FLOWS AT THE PROJECT CLOSEOUT.

- NEW WORK GENERAL NOTES**
- PROVIDE ALL LABOR, MATERIAL, AND EQUIPMENT NECESSARY TO COMPLETELY FURNISH, INSTALL, AND PLACE INTO OPERATION. ALL SYSTEMS SHOWN ON THE DRAWINGS AND DELINEATED IN THE SPECIFICATIONS IN ACCORDANCE WITH ALL STATE AND LOCAL CODES AND ORDINANCES. REPORT ANY KNOWN DISCREPANCIES TO THE ARCHITECT/ENGINEER PRIOR TO INSTALLATION.
 - REFER TO ARCHITECTURAL REFLECTED CEILING PLANS FOR EXACT LOCATIONS OF CEILING DIFFUSERS, REGISTERS AND GRILLES.
 - DO NOT SCALE DRAWINGS; REFER TO ARCHITECTURAL DRAWINGS FOR DIMENSIONED LOCATIONS OF WALLS, DOORS, WINDOWS, AND CABINETS.
 - COORDINATE WORK AND SPACE REQUIREMENTS IN CEILING SPACES WITH OTHER TRADES PRIOR TO INSTALLATION.
 - PROVIDE VOLUME DAMPERS AT ALL SUPPLY, RETURN, AND EXHAUST DUCT BRANCH TAKE-OFFS.
 - PROVIDE TURNING VANES IN ALL 90 DEGREE MITERED ELBOWS. OMIT TURNING VANES IN ACOUSTIC LINED RETURN DUCT ELBOWS.
 - PROVIDE FLEXIBLE DUCT ON INLET TO EACH CEILING DIFFUSER. CUT FLEXIBLE DUCTS TO LENGTH NEEDED AND INSTALL WITHOUT KINKS OR SHARP BENDS (BENDS WITH CENTERLINE RADIUS LESS THAN DUCT DIAMETER). SUPPORT FLEXIBLE DUCTS WITH MINIMUM 1" WIDE METAL STRAPS OR SADDLES.
 - SIZES OF ACOUSTIC LINED DUCTS ARE NET INSIDE DIMENSION. INCREASE SHEET METAL SIZE ACCORDINGLY.
 - RUNOUTS TO CEILING DIFFUSERS ARE THE SAME SIZE AS THE DIFFUSER NECK UNLESS NOTED OTHERWISE.
 - INSTALL ALL EQUIPMENT WITH CODE REQUIRED AND MANUFACTURER RECOMMENDED MINIMUM CLEARANCES FOR SERVICE ACCESS AND FIRE PROTECTION.
 - ALL MATERIALS EXPOSED WITHIN PLENUMS SHALL BE NON-COMBUSTIBLE OR SHALL HAVE A FLAME SPREAD INDEX OF NOT MORE THAN 25 AND A SMOKE DEVELOPED INDEX OF NOT MORE THAN 50 WHEN TESTED IN ACCORDANCE WITH ASTM E 84.

- DEMOLITION GENERAL NOTES**
- REMOVE EXISTING DUCTWORK, CONTROLS, AND MISCELLANEOUS HVAC EQUIPMENT NOT INTENDED FOR REUSE. FIELD VERIFY THE EXACT SCOPE PRIOR TO BID. COORDINATE ALL DEMOLITION WORK WITH THE UNIVERSITY AND GENERAL CONTRACTOR.

STANDARD HVAC ABBREVIATIONS					
AAV	AUTOMATIC AIR VENT	HOA	HEAD HAND-OFF/AUTOMATIC	RO	REVERSE OSMOSIS
ACCESS	ACCESSORIES	HOA	HAND-OFF/AUTOMATIC	RPM	REVOLUTIONS PER MINUTE
AD	ACCESS DOOR	HP	HORSEPOWER	RS	REFRIGERANT SUCTION
AFF	ABOVE FINISHED FLOOR	HPR	HIGH PRESSURE RETURN	SA	SUPPLY AIR
AMP	AMPERE	HSC	(STEAM CONDENSATE)	SAT	SUPPLY AIR TEMPERATURE
AP	ACCESS PANEL	HSTAT	HEATING STAT	SC	SHADING COEFFICIENT
APD	AIR PRESSURE DROP	HTG	HEATING	SCD	SMOKE CONTROL DAMPER
ARI	AIR CONDITIONING AND REFRIGERATION INSTITUTE	HWR	HEATING HOT WATER RETURN	SD	SMOKE DETECTOR
ASME	AMERICAN SOCIETY OF MECHANICAL ENGINEERS	HWS	HEATING HOT WATER SUPPLY	SENS	SENSIBLE HEAT
BAS	BUILDING AUTOMATION SYSTEM	HZ	HERTZ	SP	STATIC PRESSURE
BD	BACKDRAFT DAMPER	IO	INPUT/OUTPUT	ST	TESTING, ADJUSTING, BALANCE
BHP	BRAKE HORSEPOWER	IAQ	INDOOR AIR QUALITY	TAB	TOTAL DYNAMIC HEAD
BTU	BRITISH THERMAL UNIT	IN HG	INCHES OF MERCURY	TDS	TOTAL DISSOLVED SOLIDS
BTUH	BRITISH THERMAL UNIT PER HOUR	IN WC	INCH WATER COLUMN	TSP	TOTAL STATIC PRESSURE
CD	CEILING DIFFUSER	IN WG	INCH WATER GAUGE	TSTAT	THERMOSTAT
CFH	CUBIC FEET PER HOUR	INST	INSTALLED	UL	UNDERWRITERS LABORATORY
CFM	CUBIC FEET PER MINUTE	INST	INSTALLED	VAV	VARIABLE AIR VOLUME
CHWR	CHILLED WATER RETURN	KW	KILOWATT	VFD	VARIABLE FREQUENCY DRIVE
CHWS	CHILLED WATER SUPPLY	KWH	KILOWATT HOUR	WB	WET-BULB TEMPERATURE
CI	CAST IRON	LAT	LEAVING AIR TEMPERATURE	WG	WATER GAGE
CO	COOLING	LBS/HR	POUNDS PER HOUR	WPD	WATER SIDE PRESSURE DROP
CO	CARBON MONOXIDE	LF	LINEAR FOOT (FEET)	WIRE	WIRED
CO2	CARBON DIOXIDE	LPR	LOW PRESSURE RETURN		
COP	COEFFICIENT OF PERFORMANCE		(STEAM CONDENSATE)		
CV	CONSTANT VOLUME	LPS	LOW PRESSURE STEAM		
CWR	CONDENSER WATER RETURN	LWT	LEAVING WATER TEMPERATURE		
CWS	CONDENSER WATER SUPPLY	MAX	MAXIMUM		
DB	DEW POINT TEMPERATURE	MCA	MINIMUM BRANCH CIRCUIT AMPACITY		
DC	DISCONNECT	MERV	MINIMUM EFFICIENCY REPORTING VALUE		
DDC	DIRECT DIGITAL CONTROLS	MIN	MINIMUM		
DEG	DEGREE (DELTA CHANGE IN TEMPERATURE)	MOD	MOTOR OPERATED DAMPER		
DIA	DIAMETER	MPR	MEDIUM PRESSURE RETURN		
DIW	DEIONIZED WATER	MPS	MEDIUM PRESSURE STEAM		
DX	DIRECT EXPANSION	MRI	MAGNETIC RESONANCE IMAGING		
EA	EXHAUST AIR	MVD	MANUAL VOLUME DAMPER		
EAT	ENTERING AIR TEMPERATURE	NA	NOT APPLICABLE		
EER	ENERGY EFFICIENCY RATIO	NC	NOISE CRITERIA		
EG	EMERGENCY POWER	NG	NORMALLY CLOSED		
EMERG	EMERGENCY POWER	NO	NORMALLY OPEN		
ESP	EXTERNAL STATIC PRESSURE	NTS	NOT TO SCALE		
EW	ENTERING WATER TEMPERATURE	OA	OUTSIDE AIR		
EX	EXISTING	OC	OVER CURRENT PROTECTION		
F	FAHRENHEIT	PD	PARTS PER MILLION		
F&T	FLOAT AND THERMOSTATIC	PPM	PARTS PER MILLION		
FA	FIRE AREA	PRV	PRESSURE REGULATING VALVE		
FD	FIRE DAMPER	PSI	POUNDS PER SQUARE INCH		
FLA	FULL LOAD AMPERES	PSIA	POUNDS PER SQUARE INCH - ABSOLUTE		
FFM	FEET PER MINUTE	PSIG	POUNDS PER SQUARE INCH - GAGE		
FPS	FEET PER SECOND	RA	RETURN AIR		
FT	FEET	RAI	RETURN AIR TEMPERATURE		
FURN	FURNISHED	RH	RELATIVE HUMIDITY		
GA	GALLONS	RL	REFRIGERANT LIQUID LINE		
GAL	GALLONS PER MINUTE	RLA	RUN LOAD AMPERE		
GPM	GALLONS PER MINUTE				

MECHANICAL DRAWING INDEX	
SHEET NUMBER	SHEET NAME
M-001	MECHANICAL COVER SHEET
M-100	MECHANICAL DUCTWORK DEMOLITION BASEMENT PLAN OVERALL
M-100A	MECHANICAL DUCTWORK DEMOLITION BASEMENT PLAN AREA A
M-100B	MECHANICAL DUCTWORK DEMOLITION BASEMENT PLAN AREA B
M-100C	MECHANICAL DUCTWORK DEMOLITION BASEMENT PLAN AREA C
M-100D	MECHANICAL DUCTWORK DEMOLITION BASEMENT PLAN AREA D
M-101	MECHANICAL PIPING DEMOLITION BASEMENT PLAN OVERALL
M-101A	MECHANICAL PIPING DEMOLITION BASEMENT PLAN AREA A
M-101B	MECHANICAL PIPING DEMOLITION BASEMENT PLAN AREA B
M-101C	MECHANICAL PIPING DEMOLITION BASEMENT PLAN AREA C
M-101D	MECHANICAL PIPING DEMOLITION BASEMENT PLAN AREA D
M-102	MECHANICAL ZONING BASEMENT PLAN OVERALL
M-100	MECHANICAL DUCTWORK BASEMENT PLAN OVERALL
M-100A	MECHANICAL DUCTWORK BASEMENT PLAN AREA A
M-100B	MECHANICAL DUCTWORK BASEMENT PLAN AREA B
M-100C	MECHANICAL DUCTWORK BASEMENT PLAN AREA C
M-100D	MECHANICAL DUCTWORK BASEMENT PLAN AREA D
M-100	MECHANICAL PIPING BASEMENT PLAN OVERALL
M-100A	MECHANICAL PIPING BASEMENT PLAN AREA A
M-100B	MECHANICAL PIPING BASEMENT PLAN AREA B
M-100C	MECHANICAL PIPING BASEMENT PLAN AREA C
M-100D	MECHANICAL PIPING BASEMENT PLAN AREA D
M-601	MECHANICAL - DETAILS
M-601	MECHANICAL - SCHEDULES



301 East Vine Street
Lexington, Kentucky 40507
859.252.6781

RESERVED FOR AHJ STAMP



KOHR'S LONNEMANN HEIL
ENGINEERS, INC.
MECHANICAL/ELECTRICAL
ENGINEERS
WWW.KLHENGRS.COM
1538 ALEXANDRIA PIKE, SUITE 11
FT. THOMAS, KENTUCKY 41075
800-364-9783
859-442-8050
859-442-8058 FAX

BID DOCUMENTS

UK WT YOUNG LIBRARY - LOWER LEVEL RENOVATION

UNIVERSITY OF KENTUCKY
LEXINGTON, KENTUCKY

MECHANICAL


PROJECT	202586	
DATE	03.31.2026	
REVISIONS		
No.	Description	Date
1	ADDENDUM 3	04/16/26
3	ADDENDUM 6	05/01/26

JRA ARCHITECTS HAS RETAINED AN ELECTRONIC VERSION OF THESE DRAWINGS. THE CLIENT AGREES NOT TO REUSE THESE DRAWINGS - IN ELECTRONIC OR ANY OTHER FORMAT - IN WHOLE OR IN PART FOR ANY PURPOSE OTHER THAN FOR THE PROJECT. THE CLIENT AGREES NOT TO REUSE THESE ELECTRONIC FILES OR OTHERS WITHOUT THE PRIOR WRITTEN CONSENT OF THE ARCHITECT. THE CLIENT FURTHER AGREES TO WAIVE ALL CLAIMS AGAINST THE ARCHITECT RELATING IN ANY WAY FROM ANY UNAUTHORIZED CHANGES TO OR REUSE OF THE ELECTRONIC FILES FOR ANY OTHER PROJECT BY ANYONE OTHER THAN THE ARCHITECT.

MECHANICAL COVER SHEET


M-001

COPYRIGHT 2025 - JRA, INC.

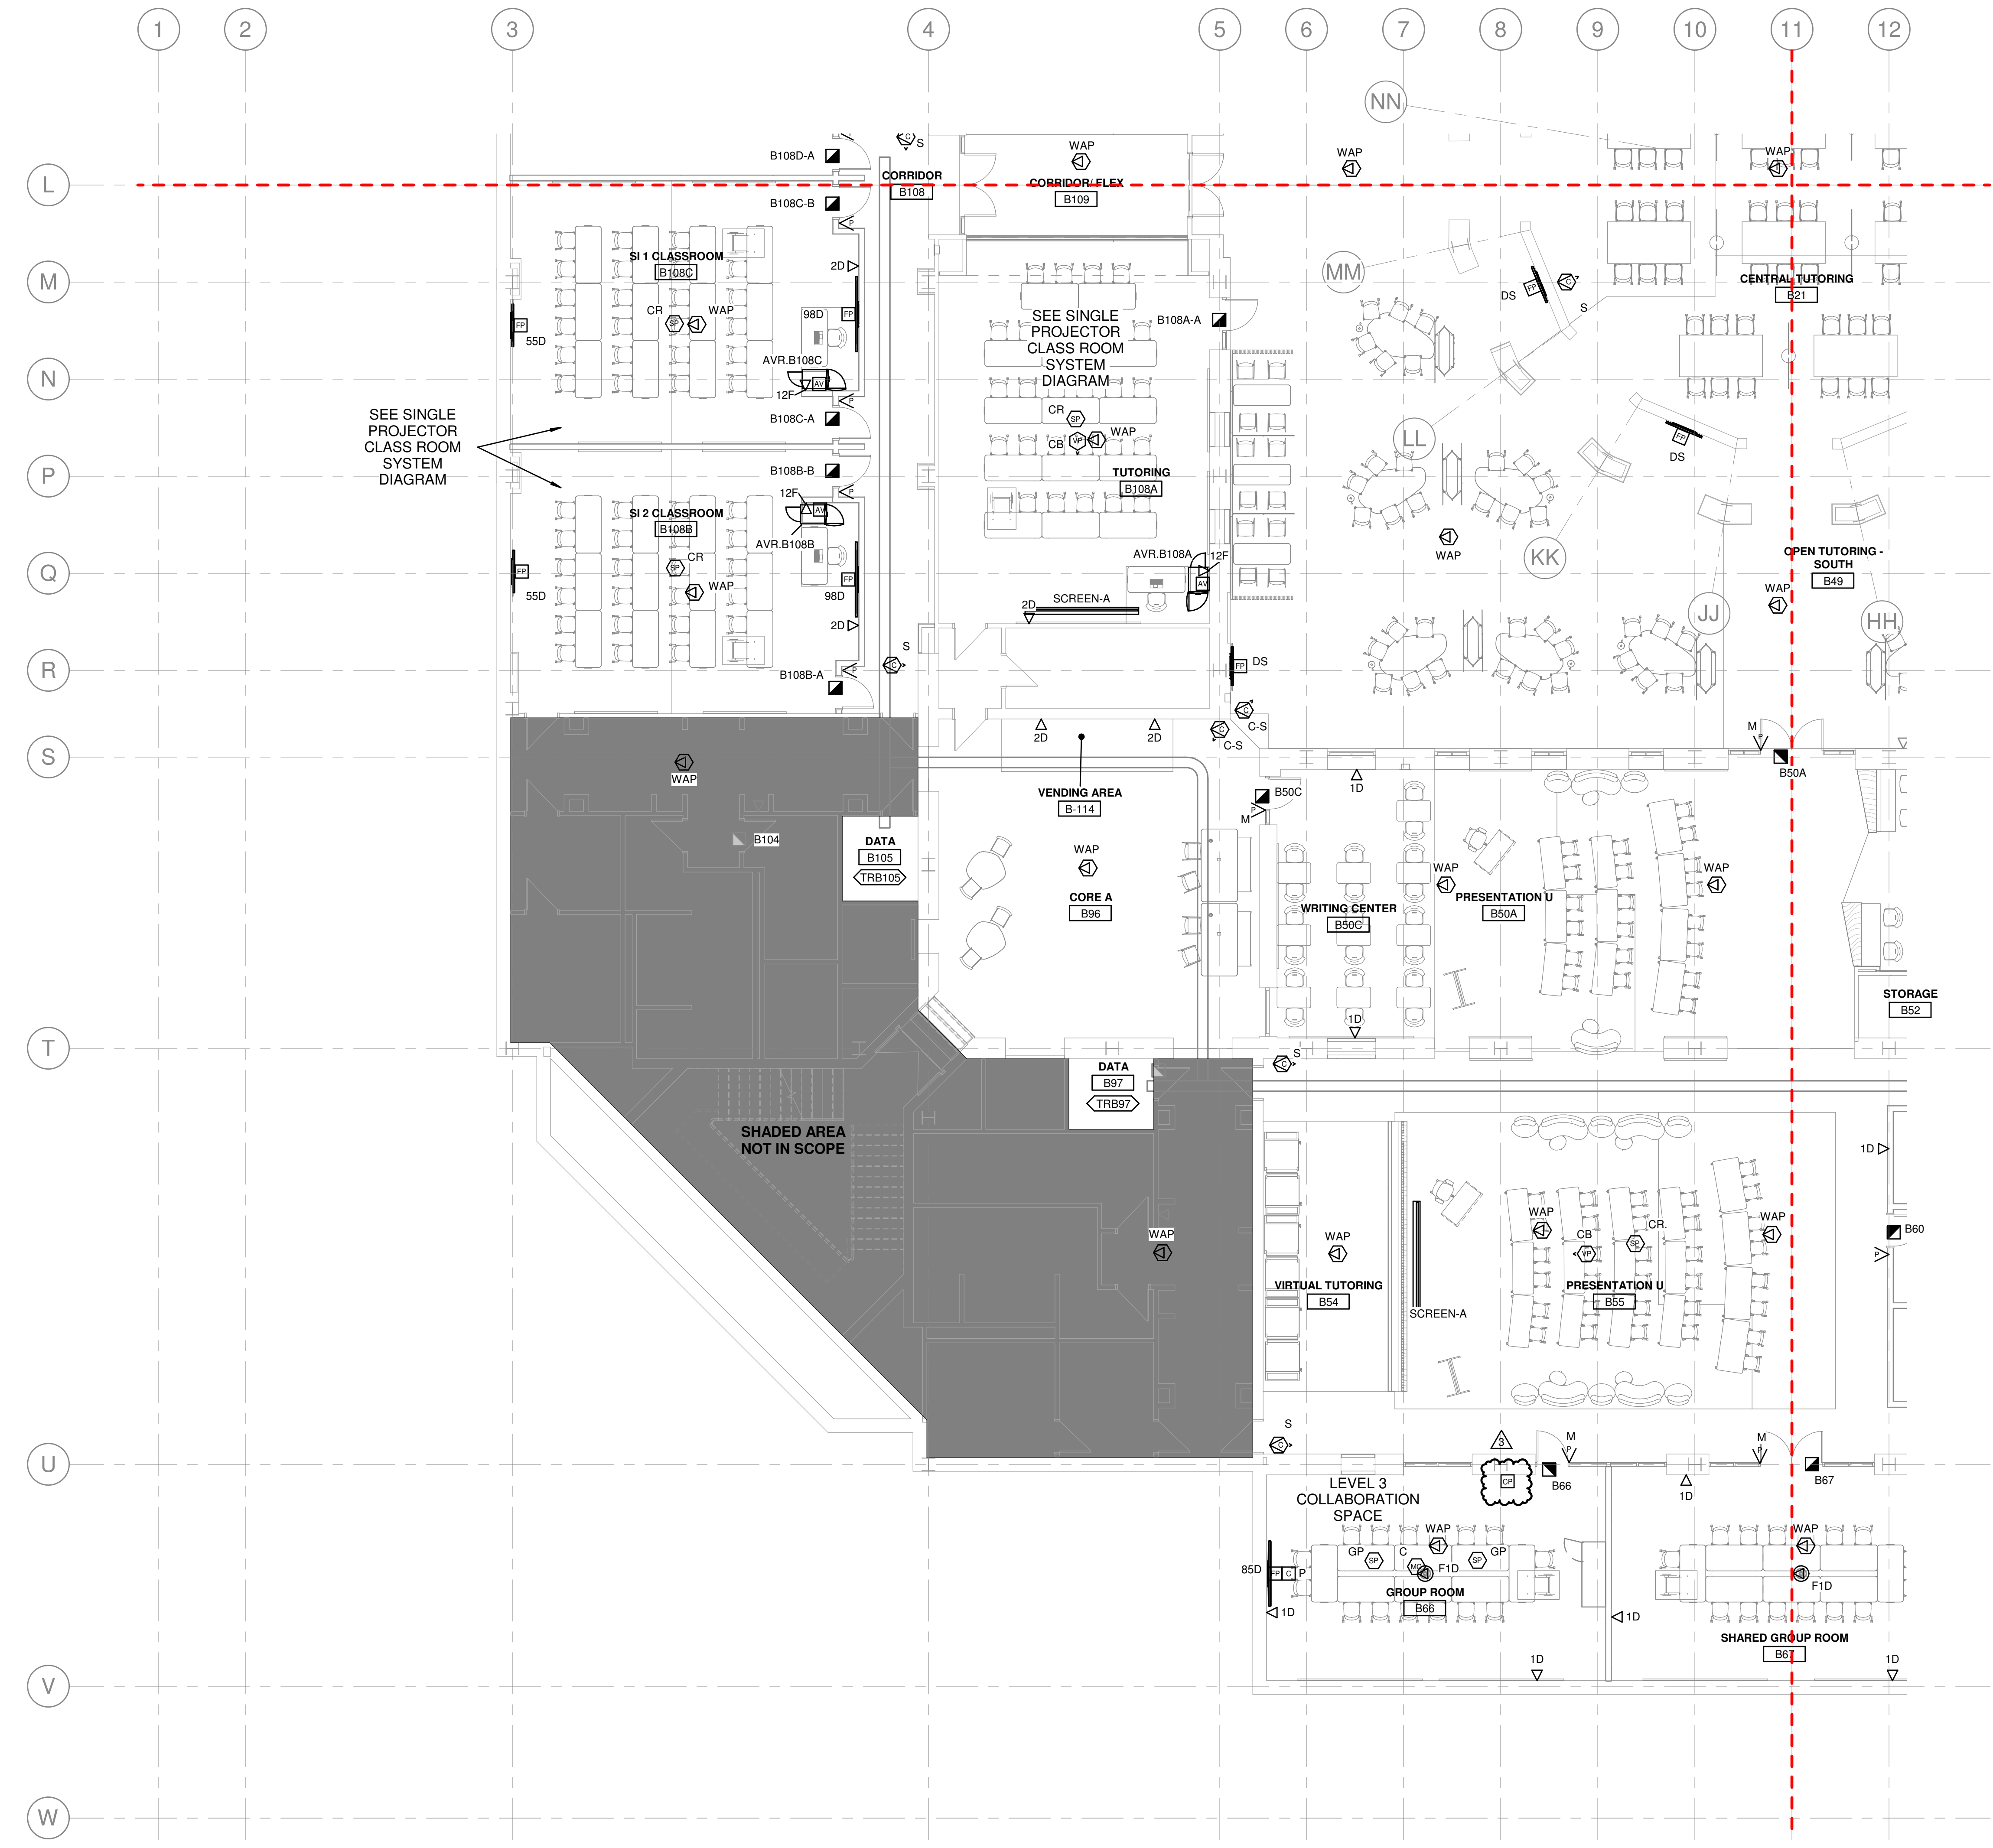

1 TECHNOLOGY PLAN - BASEMENT - AREA A
1/8" = 1'-0"

KEYED NOTES

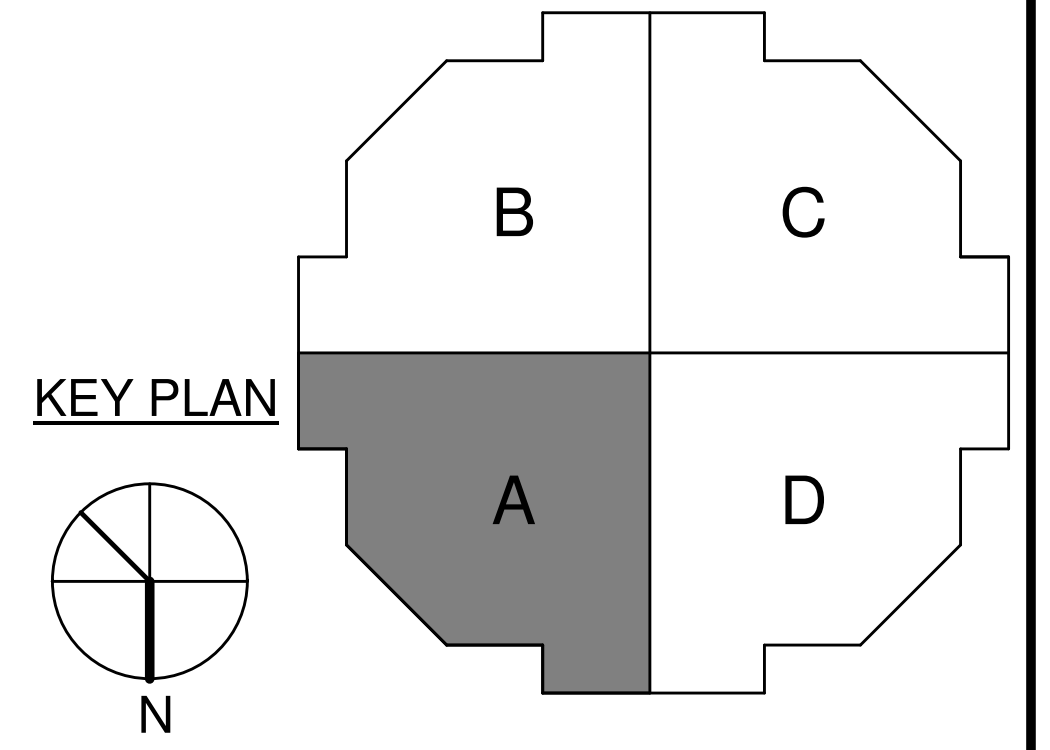

301 East Vine Street
Lexington, Kentucky 40507
859.252.6781

RESERVED FOR AHJ STAMP



KOHR'S LONNEMANN HEIL
ENGINEERS, INC.
MECHANICAL/ELECTRICAL
ENGINEERS
WWW.KLHENGRS.COM
1538 ALEXANDRIA PIKE, SUITE 11
FT. THOMAS, KENTUCKY 41075
800-564-9783
859-442-8050
859-442-8058 FAX

BID DOCUMENTS
UK WT YOUNG LIBRARY - LOWER LEVEL RENOVATION
UNIVERSITY OF KENTUCKY
LEXINGTON, KENTUCKY

TECHNOLOGY

PROJECT	202586
DATE	03.31.2026


REVISIONS		
No.	Description	Date
3	ADDENDUM 6	05/01/26

JRA ARCHITECTS HAS RETAINED AN ELECTRONIC VERSION OF THESE DRAWINGS. THE CLIENT AGREES NOT TO REUSE THESE DRAWINGS IN ELECTRONIC OR ANY OTHER FORMAT IN WHOLE OR IN PART FOR ANY PURPOSE OTHER THAN FOR THE PROJECT. THE CLIENT AGREES NOT TO TRANSMIT THESE ELECTRONIC FILES TO OTHERS WITHOUT THE PRIOR WRITTEN CONSENT OF THE ARCHITECT. THE CLIENT FURTHER AGREES TO WAIVE ALL CLAIMS AGAINST THE ARCHITECT RESULTING IN ANY WAY FROM ANY UNAUTHORIZED CHANGES TO OR REUSE OF THE ELECTRONIC FILES FOR ANY OTHER PROJECT BY ANYONE OTHER THAN THE ARCHITECT.

TECHNOLOGY BASEMENT PLAN AREA A

T-100A


COPYRIGHT 2025 - JRA, INC.

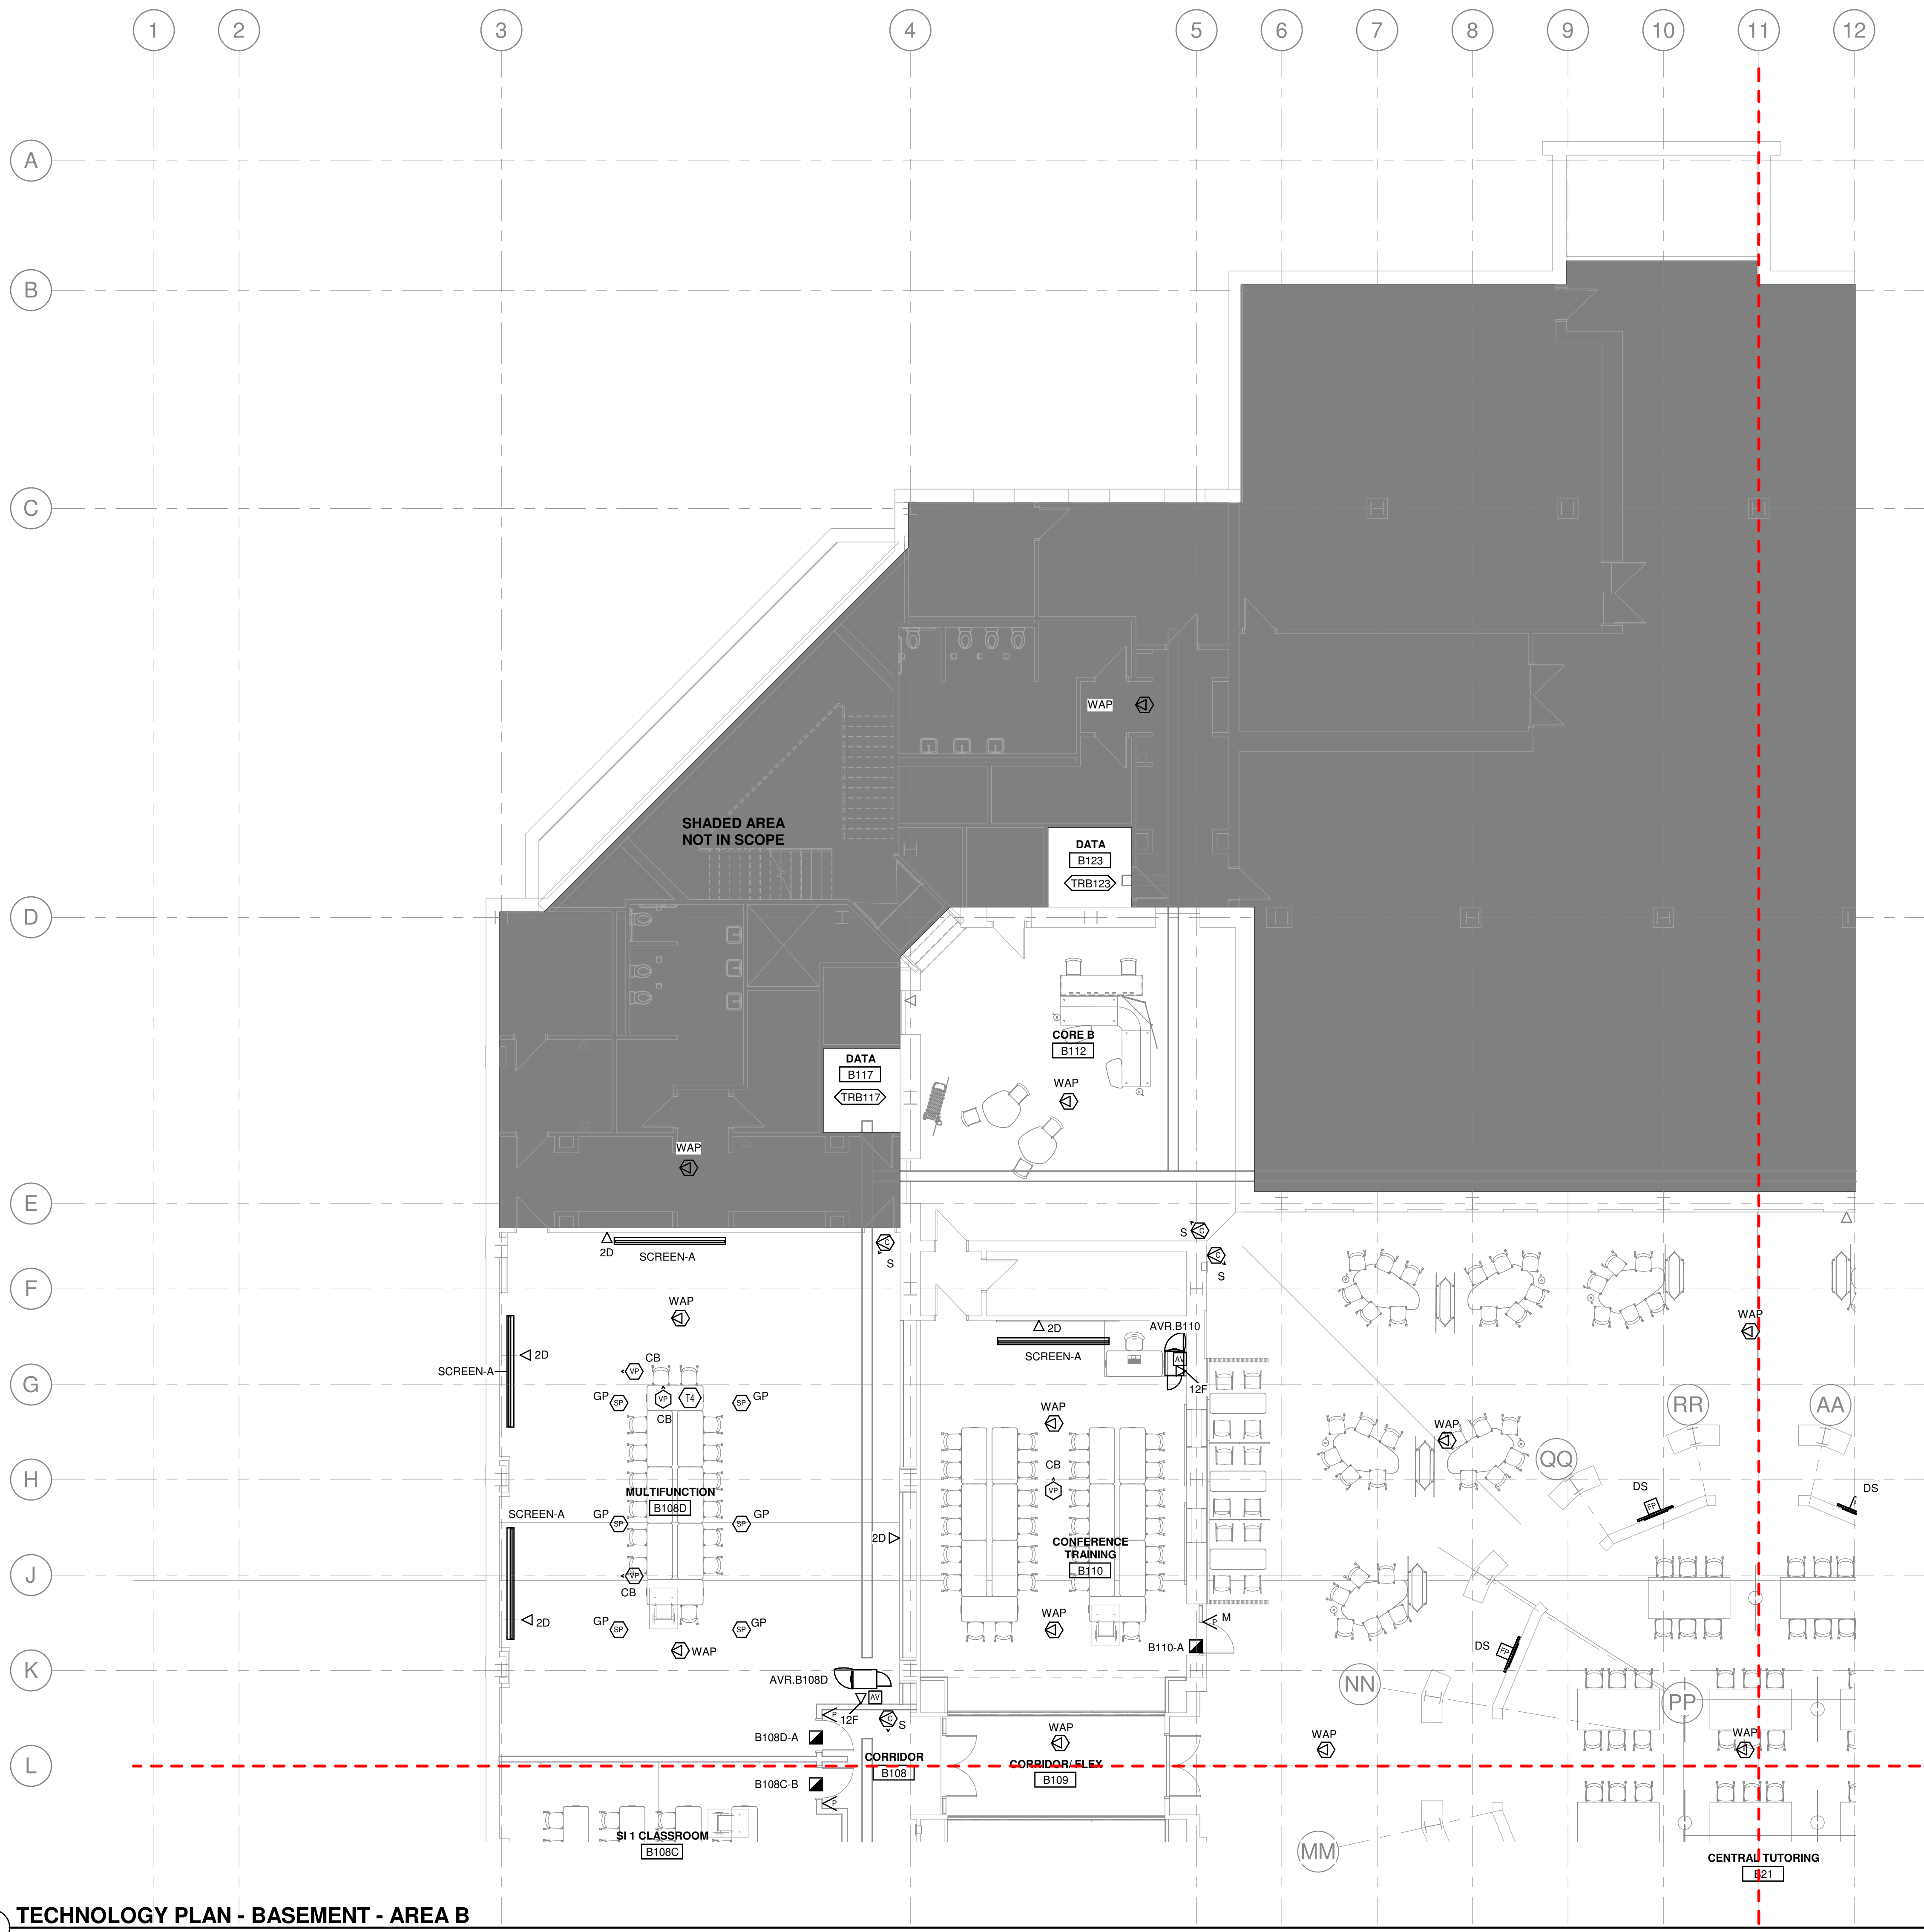

1 TECHNOLOGY PLAN - BASEMENT - AREA B
1/8" = 1'-0"

KEYED NOTES

T4 SEE DUAL PROJECTOR SYSTEM DIAGRAM. ADD (1) ADDITIONAL PROJECTOR AND SCREEN. PROVIDE "GP" TYPE SPEAKER INSTEAD OF OR. THESE NOTES ONLY APPLY TO ROOM B108D. EXPAND MATRIX AS NEEDED TO ACCOMMODATE ADDITIONAL OUTPUT.

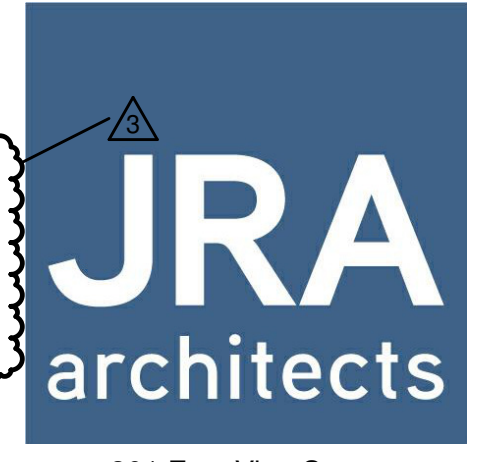

301 East Vine Street
Lexington, Kentucky 40507
859.252.6781

RESERVED FOR AHJ STAMP



BID DOCUMENTS
UK WT YOUNG LIBRARY - LOWER LEVEL RENOVATION
UNIVERSITY OF KENTUCKY
LEXINGTON, KENTUCKY


TECHNOLOGY		
PROJECT	202586	
DATE	03.31.2026	
REVISIONS		
No.	Description	Date
3	ADDENDUM 6	05/01/26

JRA ARCHITECTS HAS RETAINED AN ELECTRONIC VERSION OF THESE DRAWINGS. THE CLIENT AGREES NOT TO REUSE THESE DRAWINGS IN ELECTRONIC OR ANY OTHER FORMAT IN WHOLE OR IN PART FOR ANY PURPOSE OTHER THAN FOR THE PROJECT. THE CLIENT AGREES NOT TO TRANSMIT THESE ELECTRONIC FILES TO OTHERS WITHOUT THE PRIOR WRITTEN CONSENT OF THE ARCHITECT. THE CLIENT FURTHER AGREES TO WAIVE ALL CLAIMS AGAINST THE ARCHITECT RESULTING IN ANY WAY FROM ANY UNAUTHORIZED CHANGES TO OR REUSE OF THE ELECTRONIC FILES FOR ANY OTHER PROJECT BY ANYONE OTHER THAN THE ARCHITECT.

TECHNOLOGY BASEMENT PLAN AREA B


T-100B

COPYRIGHT 2025 - JRA, INC.

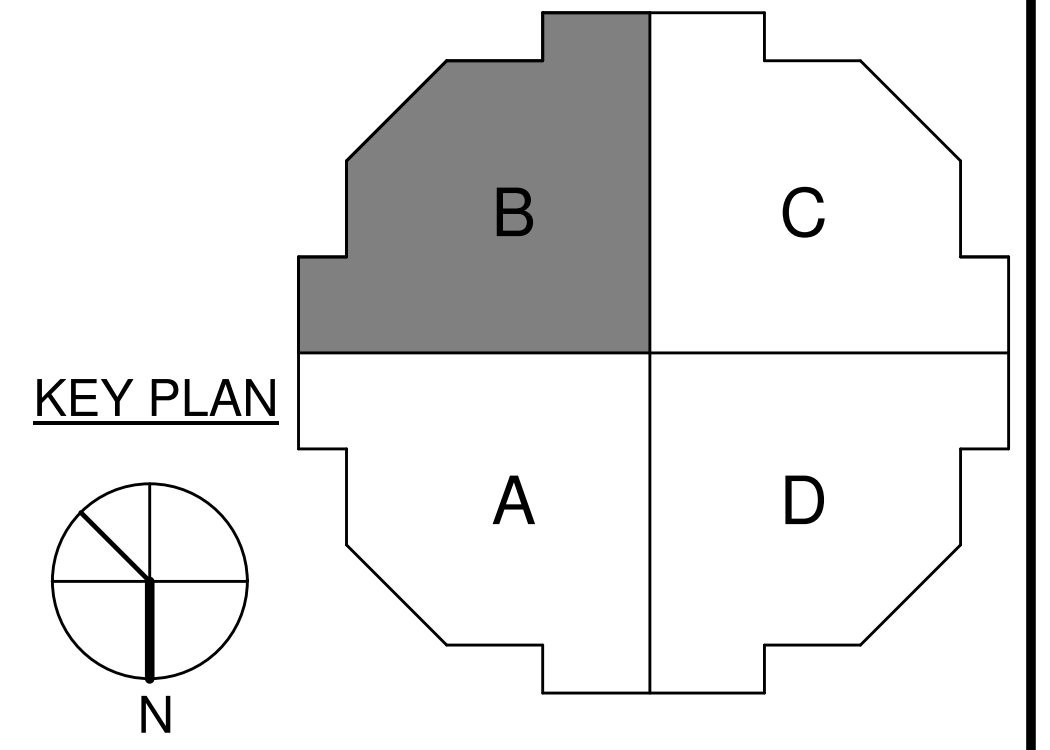

GENERAL NOTES

- A. OVERALL SYSTEM DIAGRAMS SHOWN ARE UK STANDARDS WITH PROJECT SPECIFIC NOTES.
- B. CONTRACTOR TO REFERENCE UK STANDARDS AT <https://facilities.uky.edu/planning-design-construction/capital-projects/design-standards/division/19>

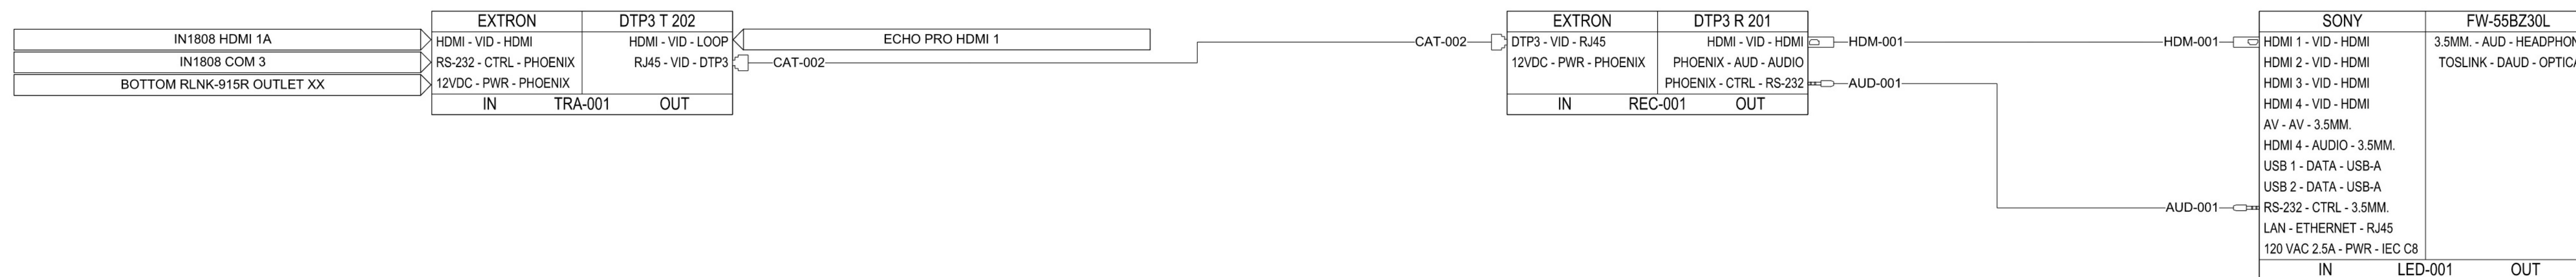


UK SINGLE PROJECTOR CLASSROOM CONFIDENCE MONITOR

ADD-ON
1/8" = 1'-0"

RESERVED FOR AHJ STAMP

KLH ENGINEERS
KOHRS LONNEMANN HEIL
ENGINEERS, INC.
MECHANICAL/ELECTRICAL
ENGINEERS
WWW.KLHENGERS.COM
1538 ALEXANDRIA PIKE, SUITE 11
FT. THOMAS, KENTUCKY 41075
800-564-9783
859-442-8050
859-442-8058 FAX

BID DOCUMENTS
UK WT YOUNG LIBRARY - LOWER LEVEL RENOVATION
UNIVERSITY OF KENTUCKY
LEXINGTON, KENTUCKY

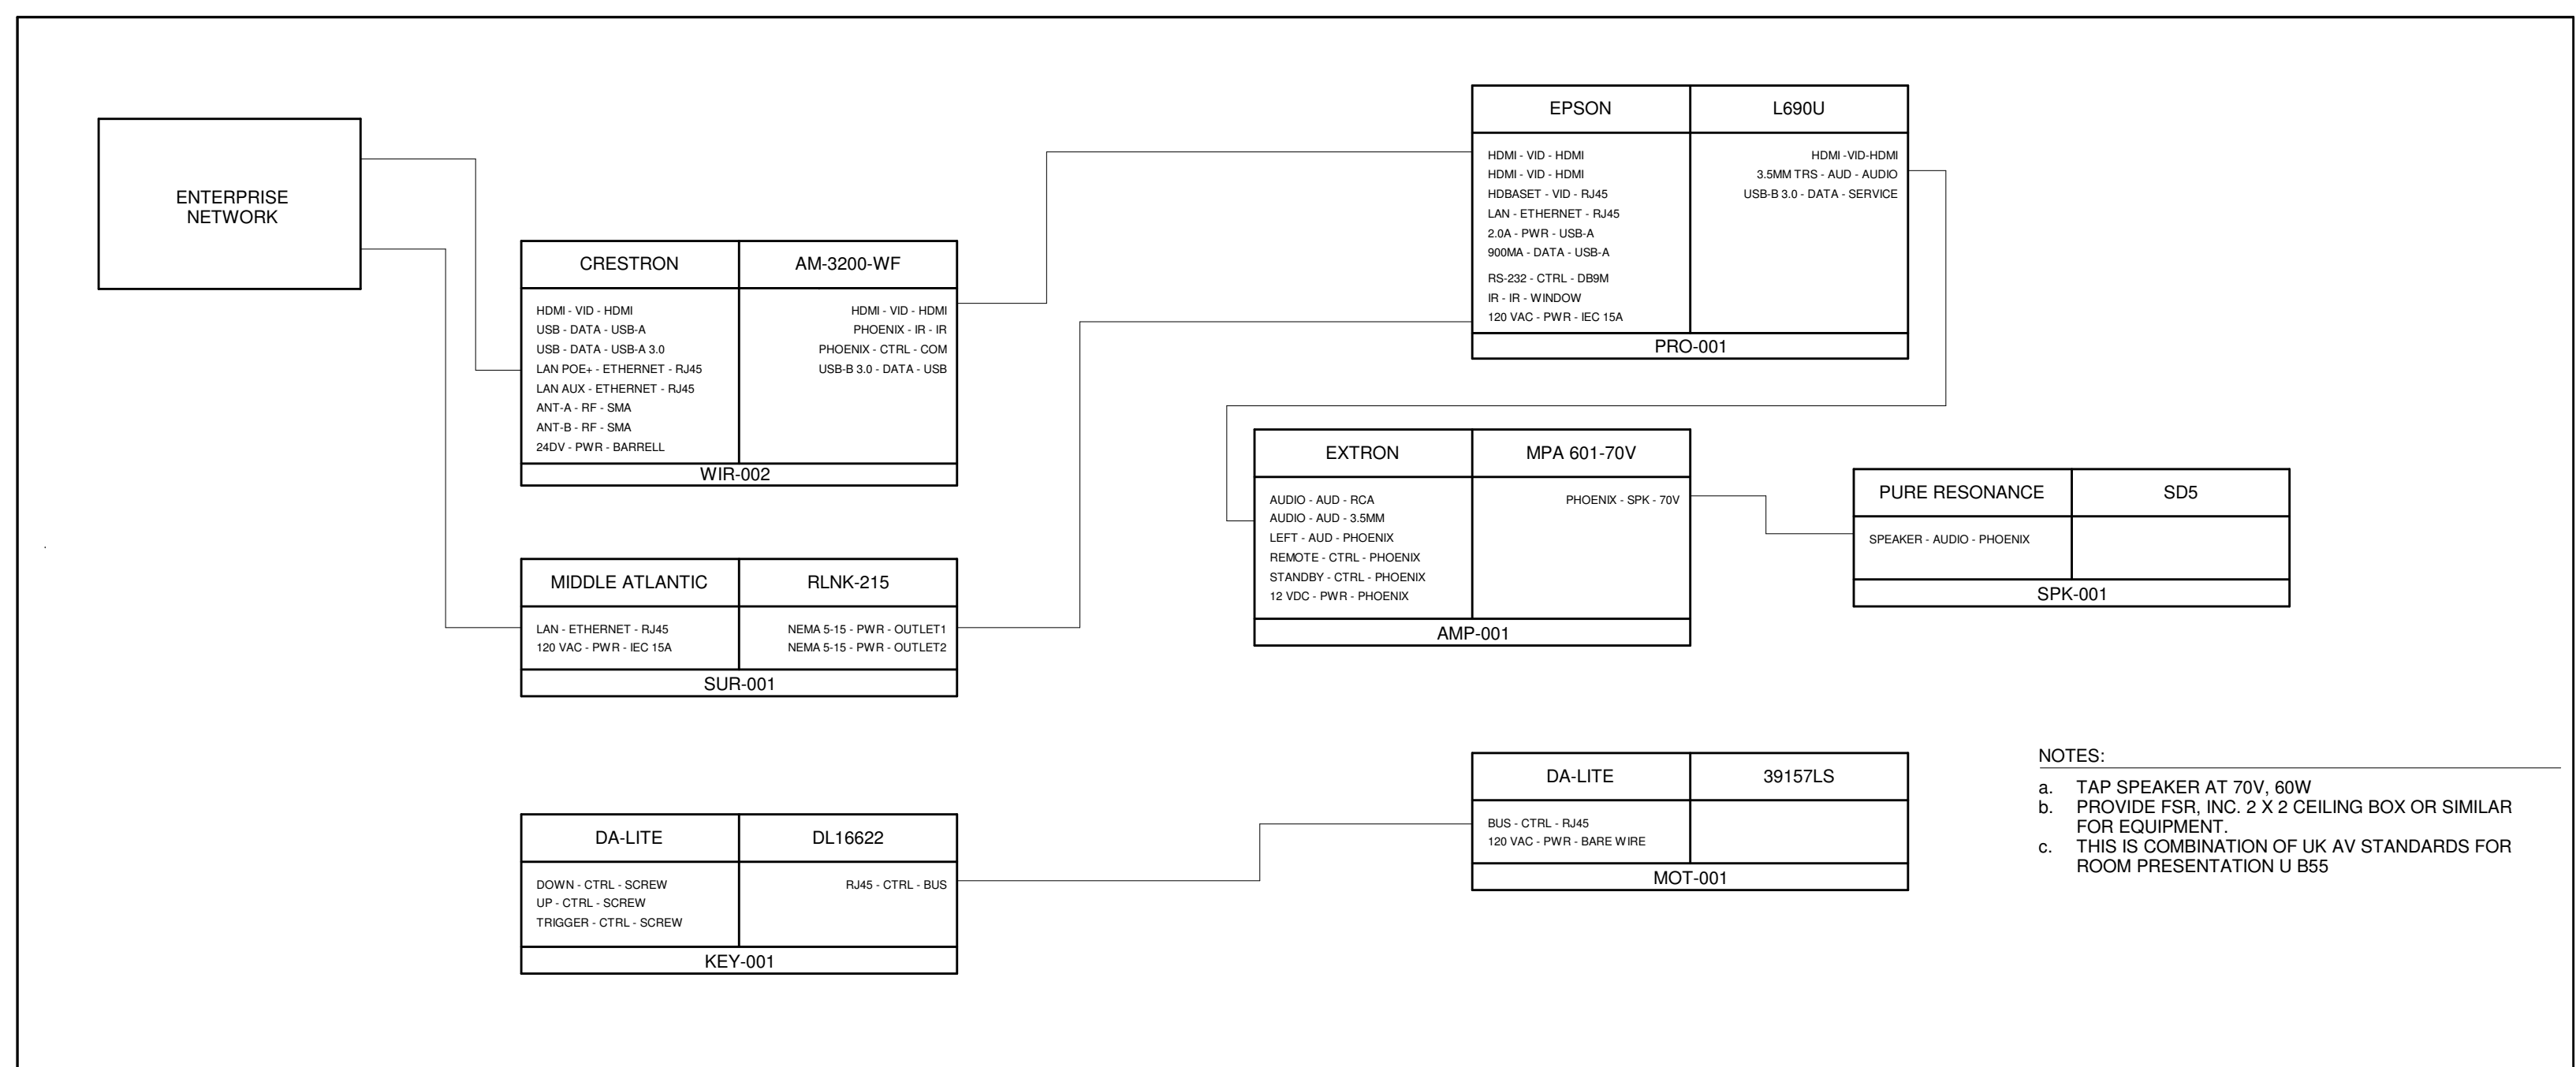

PRESENTATION U B55 AV SYSTEM

1/8" = 1'-0"

- NOTES:
- a. TAP SPEAKER AT 70V 80W
 - b. PROVIDE FSR, INC. 2 X 2 CEILING BOX OR SIMILAR FOR EQUIPMENT
 - c. THIS IS COMBINATION OF UK AV STANDARDS FOR ROOM PRESENTATION U B55

Collaboration Space Level 3

Manufacturer	Model	Description	Quantity	Provided by GC	Provided by Owner	Installed by
Crestron	AM-3200-WF	Wireless presentation system	1	Yes	No	GC
Sony	FW-xxBZ30L	Professional display. See schedule.	1	Yes	No	GC
Crestron	TSW-770-B-S	Touch panel	1	Yes	No	GC
Crestron	CEN-ODT-C-POE	Occupancy sensor	1	Yes	No	GC
Middle Atlantic	RLNK-215	Surface-mount power strip	1	Yes	No	GC
Crestron	AM-TX3-100	USB-C transmitter	1	Yes	No	GC
Shure	P300-IMX	Audio DSP	1	Yes	No	GC
Sennheiser	TeamConnect Ceiling 2	Ceiling microphone array	1	Yes	No	GC
JBL	Control 226CT	Ceiling speaker	2	Yes	No	GC
Extron	MPA 601-70V	70V audio amplifier	1	Yes	No	GC
Crestron	IV-CAM-112-B	PTZ camera	1	Yes	No	GC
Commscope		Network patch cords	*	Yes	No	GC
Varies	Varies	Power and AV patch cords	*	Yes	No	GC

SYSTEM NOTES

- A. THESE SCHEDULES ARE EXTRACTED FROM THE UNIVERSITY OF KENTUCKY AV STANDARDS FOR A 'COLLABORATION SPACE LEVEL 3'.
- B. SEE UNIVERSITY OF KENTUCKY STANDARDS FOR FULL CONNECTIVITY DIAGRAM.
 - a. <https://facilities.uky.edu/planning-design-construction/capital-projects/official-design-standards>
- C. SEE SCHEDULES FOR DISPLAY SIZES.
- D. PROVIDE MOUNTS FOR ALL TVS AND PROJECTORS. MOUNTS TO BE INSTALLED BY GC IN ACCORDANCE TO UK GUIDELINES. AV CONTRACTOR IS NOT TO INSTALL MOUNTS.
- E. PROVIDE SPECTRUM LECTERN MODEL 20002. VERIFY FINISH BEFORE ORDERING.

UK COLLABORATION SYSTEM LEVEL 3

1/8" = 1'-0"

TECHNOLOGY

PROJECT	202586
DATE	03.31.2026

REVISIONS

No.	Description	Date
3	ADDENDUM 6	05/01/26

JRA ARCHITECTS HAS RETAINED AN ELECTRONIC VERSION OF THESE DRAWINGS. THE CLIENT AGREES NOT TO REUSE THESE DRAWINGS - IN ELECTRONIC OR ANY OTHER FORMAT - IN WHOLE OR IN PART FOR ANY PURPOSE OTHER THAN FOR THE PROJECT. THE CLIENT AGREES NOT TO TRANSMIT THESE ELECTRONIC FILES TO OTHERS WITHOUT THE PRIOR WRITTEN CONSENT OF THE ARCHITECT. THE CLIENT FURTHER AGREES TO WAIVE ALL CLAIMS AGAINST THE ARCHITECT RESULTING IN ANY WAY FROM ANY UNAUTHORIZED CHANGES TO OR REUSE OF THE ELECTRONIC FILES FOR ANY OTHER PROJECT BY ANYONE OTHER THAN THE ARCHITECT.

TECHNOLOGY AV SYSTEMS

T-641

COPYRIGHT 2025 - JRA, INC.

AV COMPONENTS AND PERIPHERALS

Manufacturer	Model	Description	Quantity	Provided by GC	Provided by Owner	Installed by
Lumens	PC193	Document camera	1	Yes	No	GC
Shure	MX393/O	Boundary microphone	1	Yes	No	GC
Echo360	ES-HW-PRO002	Lecture capture appliance	1	Yes	No	GC
Dell	QBS1250	Instructor PC	1	Yes	No	GC
Dell	P2225H	Instructor monitor	1	Yes	No	GC
Extron	IN1808 IPCP Q MA 70 LL	AV switcher & control processor	1	Yes	No	GC
Epson	L690U	Laser projector	1	Yes	No	GC
Da-Lite	39157LS	Motorized projection screen	1	Yes	No	GC
Crestron	AM-3100-WF	Wireless presentation gateway	1	Yes	No	GC
Epiphany	AV io HD+	USB capture device	1	Yes	No	GC
Extron	DTP HDMI 4K 230 RX	HDBaseT receiver	1	Yes	No	GC
Extron	DA2 HD 4K Plus	HDMI distribution amplifier	1	Yes	No	GC
Pure Resonance	SD5	Ceiling speaker	1	Yes	No	GC
Middle Atlantic	ERK-2128LRD	Equipment rack	1	Yes	No	GC
Varies	Varies	Patch cords	*	Yes	No	GC
Anker	A7505	USB hub	1	Yes	No	GC
Extron	70-1235-02	USB panel adapter	1	Yes	No	GC
Comprehensive	HDJ-J	Adapter	5	Yes	No	GC
Extron	EBP200	Panel adapter	1	Yes	No	GC
Da-Lite	DL16622	Key switch	1	Yes	No	GC

NETWORK AND PROCESSING

Manufacturer	Model	Description	Quantity	Provided by GC	Provided by Owner	Installed by
Cisco	C9300L-24P-4X-E	Network switch	1	No	Yes	OWNER
Axis	M4216-V	IP camera	1	Yes	No	GC
Commscope	Varies	Patch cords	*	Yes	No	GC
Comscope	012ZD9-T1301-M2	Network fiber	1	Yes	No	GC

POWER CONDITIONING AND DISTRIBUTION

Manufacturer	Model	Description	Quantity	Provided by GC	Provided by Owner	Installed by
Middle Atlantic	RLNK-915R	Rack-mounted PDU	2	Yes	No	GC
Middle Atlantic	RLNK-215	Rack-mounted PDU	1	Yes	No	GC
Furman	M-8X2	Power conditioner	1	Yes	No	GC
Tripp Lite	602-15	Power strip	1	Yes	No	GC
Middle Atlantic	QBP-2	Rack fan	2	Yes	No	GC
Extron	60-1936-02	Table mount outlet	1	Yes	No	GC

SYSTEM NOTES

- A. THESE SCHEDULES ARE EXTRACTED FROM THE UNIVERSITY OF KENTUCKY AV STANDARDS FOR A 'SINGLE PROJECTOR CLASSROOM'.
- B. SEE UNIVERSITY OF KENTUCKY STANDARDS FOR FULL CONNECTIVITY DIAGRAM.
 - a. <https://facilities.uky.edu/planning-design-construction/capital-projects/official-design-standards>
- C. SEE SCHEDULES FOR DISPLAY SIZES.
- D. SEE FLOOR PLANS FOR DISPLAY TYPES.
- E. SEE FLOOR PLANS FOR CONFERENCE DISPLAY LOCATIONS.
- F. ALL CONNECTIONS BETWEEN EQUIPMENT RACK AND WORK SURFACE ARE TO BE EASILY DETACHED.
 - a. HDMI CABLES ARE TO BE COUPLED UNDER WORK SURFACE.
 - b. USB CONNECTIONS FOR MOUSE AND KEYBOARD ARE TO BE CONNECTED TO USB EXTENSION CABLES UNDER WORK SURFACE. USB CONNECTIONS FOR TABLE JACKS ARE TO BE CONNECTED TO A-B CABLES UNDER WORK SURFACE.
- G. CONNECTION BETWEEN CAMERA AND EQUIPMENT RACK IS MADE WITH AN AOC HDMI CABLE. TO REDUCE STRAIN, AOC CABLE IS TO BE COUPLED TO A STANDARD HDMI CABLE AT BOTH ENDS. COUPLER AND CABLES SHALL BE FASTENED SECURELY TO STRUCTURE OR EQUIPMENT RACK TO REDUCE STRAIN.
- H. ENABLE PHANTOM POWER FOR MIC 1 INPUT WITHIN CROSSPOINT SETTINGS.
- I. TAP SPEAKER AT 70V, 60W.
- J. NETWORK SWITCH IS CONFIGURED BY UNIVERSITY OF KENTUCKY IT SERVICES WITH MULTIPLE VLANS. SWITCH MUST BE CONNECTED IN ACCORDANCE WITH THIS SCHEMATIC IN ORDER FOR SYSTEM TO OPERATE PROPERLY.
- K. PROJECTION SCREEN TO BE HARD WIRED TO BUILDING ELECTRICAL SYSTEM BY LICENSED ELECTRICIAN. SEE AV RACEWAY RISE DIAGRAM FOR FURTHER DETAILS.
- L. EQUIPMENT RACK TO BE BONDED TO BUILDING ELECTRICAL GROUND BY LICENSED ELECTRICIAN. MINIMUM 6AWG GREEN THHN REQUIRED.
- M. PROVIDE MOUNTS FOR ALL TVs OR PROJECTORS. MOUNTS TO BE INSTALLED BY GC IN ACCORDANCE TO UK GUIDELINES. AV CONTRACTOR IS NOT TO INSTALL MOUNTS.
- N. PROVIDE SPECTRUM LECTERN MODEL 20002. VERIFY FINISH BEFORE ORDERING.

UK SINGLE PROJECTOR CLASSROOM

1/8" = 1'-0"

Collaboration Space Level 2

Manufacturer	Model	Description	Quantity	Provided by GC	Provided by Owner	Installed by
Crestron	AM-3200-WF	Wireless presentation system	1	Yes	No	GC
Sony	FW-xxBZ30L	Professional display. See Schedule	1	Yes	No	GC
Comprehensive	WPPT-HD1-AC	HDMI wall plate	1	Yes	No	GC
Crestron	TSW-770-B-S	Touch panel	1	Yes	No	GC
Crestron	CEN-ODT-C-POE	Occupancy sensor	1	Yes	No	GC
Middle Atlantic	RLNK-215	Surface-mount power strip	1	Yes	No	GC
Crestron	AM-TX3-100	USB-C transmitter	1	Yes	No	GC
Crestron	UC-SB1-CAM	USB soundbar with camera	1	Yes	No	GC
Commscope	Varies	Network patch cords	*	Yes	No	GC
Varies	Varies	Power and AV patch cords	*	Yes	No	GC

SYSTEM NOTES

- A. THESE SCHEDULES ARE EXTRACTED FROM THE UNIVERSITY OF KENTUCKY AV STANDARDS FOR A 'COLLABORATION SPACE LEVEL 2'.
- B. SEE UNIVERSITY OF KENTUCKY STANDARDS FOR FULL CONNECTIVITY DIAGRAM.
 - a. <https://facilities.uky.edu/planning-design-construction/capital-projects/official-design-standards>
- C. SEE SCHEDULES FOR DISPLAY SIZES.
- D. PROVIDE MOUNTS FOR ALL TVs AND PROJECTORS. MOUNTS TO BE INSTALLED BY GC IN ACCORDANCE TO UK GUIDELINES. AV CONTRACTOR IS NOT TO INSTALL MOUNTS.

UK COLLABORATION SYSTEM LEVEL 2

1/8" = 1'-0"

Collaboration Space Level 1

Manufacturer	Model	Description	Quantity	Provided by GC	Provided by Owner	Installed by
Crestron	AM-3200-WF	Wireless presentation system	1	Yes	No	GC
Sony	FW-xxBZ30L	Professional display. See schedule.	1	Yes	No	GC
Comprehensive	WPPT-HD1-AC	HDMI wall plate	1	Yes	No	GC
Crestron	TSW-770-B-S	Touch panel	1	Yes	No	GC
Crestron	CEN-ODT-C-POE	Occupancy sensor	1	Yes	No	GC
Crestron	AM-TX3-100	USB-C transmitter	1	Yes	No	GC
Middle Atlantic	RLNK-215	Surface mount power strip	1	Yes	No	GC
Commscope	Varies	Network patch cords	*	Yes	No	GC
Varies	Varies	Power and AV	*	Yes	No	GC

SYSTEM NOTES

- A. THESE SCHEDULES ARE EXTRACTED FROM THE UNIVERSITY OF KENTUCKY AV STANDARDS FOR A 'COLLABORATION SPACE LEVEL 1'.
- B. SEE UNIVERSITY OF KENTUCKY STANDARDS FOR FULL CONNECTIVITY DIAGRAM.
 - a. <https://facilities.uky.edu/planning-design-construction/capital-projects/official-design-standards>
- C. SEE SCHEDULES FOR DISPLAY SIZES.
- D. PROVIDE MOUNTS FOR ALL TVs AND PROJECTORS. MOUNTS TO BE INSTALLED BY GC IN ACCORDANCE TO UK GUIDELINES. AV CONTRACTOR IS NOT TO INSTALL MOUNTS.

UK COLLABORATION SYSTEM LEVEL 1

1/8" = 1'-0"

TECHNOLOGY

PROJECT 202586

DATE 03.31.2026

REVISIONS

No.	Description	Date
3	ADDENDUM 6	05/01/26

JRA ARCHITECTS HAS RETAINED AN ELECTRONIC VERSION OF THESE DRAWINGS. THE CLIENT AGREES NOT TO REUSE THESE DRAWINGS IN ELECTRONIC OR ANY OTHER FORMAT, IN WHOLE OR IN PART, FOR ANY PURPOSE OTHER THAN FOR THE PROJECT. THE CLIENT AGREES NOT TO TRANSFER THESE ELECTRONIC FILES TO OTHERS WITHOUT THE PRIOR WRITTEN CONSENT OF THE ARCHITECT. THE CLIENT FURTHER AGREES TO WAIVE ALL CLAIMS AGAINST THE ARCHITECT RESULTING IN ANY WAY FROM ANY UNAUTHORIZED CHANGES TO OR REUSE OF THE ELECTRONIC FILES FOR ANY OTHER PROJECT BY ANYONE OTHER THAN THE ARCHITECT.

TECHNOLOGY
AV SYSTEMS

T-642

COPYRIGHT 2025 - JRA, INC.

AV COMPONENTS AND PERIPHERALS

Manufacturer	Model	Description	Quantity	Provided by GC	Provided by Owner	Installed by
Shure	MX393/O	Boundary Microphone	1	Yes	No	GC
Echo360	ES-HW-PRO002	Lecture Capture Appliance	1	Yes	No	GC
Dell	QBS1250	Instructor PC	1	Yes	No	GC
Dell	P2225H	Instructor Monitor	1	Yes	No	GC
Epson	L690U	Laser Projector	2	Yes	No	GC
Crestron	AM-3100-WF	Wireless Presentation Gateway	1	Yes	No	GC
Epiphany	AV.io HD+	USB Capture Device	1	Yes	No	GC
Pure Resonance	SD5	Ceiling Speaker	1	Yes	No	GC
Da-Lite	39157LS	Motorized Projection Screen	2	Yes	No	GC
Middle Atlantic	ERK-2128LRD	Equipment rack	1	Yes	No	GC
Varies	Varies	Patch cords	*	Yes	No	GC
Anker	A7505	USB hub	1	Yes	No	GC
Extron	70-1235-02	USB panel adapter	1	Yes	No	GC
Comprehensive	HDJ-J	Adapter	5	Yes	No	GC
Lumens	PC193	Document Camera	1	Yes	No	GC
Extron	DA2 HD 4K Plus	HDMI distribution amplifier	2	Yes	No	GC
Da-Lite	DL16622	Key switch	2	Yes	No	GC
Extron	DTP3 R 201	HDBase1 Receiver	2	Yes	No	GC

NETWORK AND PROCESSING

Manufacturer	Model	Description	Quantity	Provided by GC	Provided by Owner	Installed by
Cisco	C9300L-24P-4X-E	Network Switch	1	No	Yes	OWNER
Axis	M4216-V	IP Camera	1	Yes	No	GC
Extron	DTP3 CrossPoint 622 IPCP A LL	AV Switcher & Control	1	Yes	No	GC
Varies	Varies	Patch cords	*	Yes	No	GC
Coming	012ZD9-T1301-M2	Network fiber	1	Yes	No	GC
Extron	TLP PRO 725T B	Control surface	1	Yes	No	GC

POWER CONDITIONING AND DISTRIBUTION

Manufacturer	Model	Description	Quantity	Provided by GC	Provided by Owner	Installed by
Middle Atlantic	RLNK-915R	Rack-mounted PDU	2	Yes	No	GC
Middle Atlantic	RLNK-215	Rack-mounted PDU	2	Yes	No	GC
Furman	M-8X2	Power Conditioner	1	Yes	No	GC
Tripp Lite	602-15	Power Strip	1	Yes	No	GC
Middle Atlantic	QBP-2	Rack fan	2	Yes	No	GC
Extron	60-1936-02	Table mount outlet	1	Yes	No	GC

SYSTEM NOTES


- A. THESE SCHEDULES ARE EXTRACTED FROM THE UNIVERSITY OF KENTUCKY AV STANDARDS FOR A DUAL PROJECTOR CLASSROOM.
- B. SEE UNIVERSITY OF KENTUCKY STANDARDS FOR FULL CONNECTIVITY DIAGRAM.
 - a. <https://facilities.uky.edu/planning-design-construction/capital-projects/official-design-standards>
- C. SEE SCHEDULES FOR DISPLAY SIZES.
- D. SEE FLOOR PLANS FOR DISPLAY TYPES.
- E. SEE FLOOR PLANS FOR CONFERENCE DISPLAY LOCATIONS.
- F. ALL CONNECTIONS BETWEEN EQUIPMENT RACK AND WORK SURFACE ARE TO BE EASILY DETACHED.
 - a. HDMI CABLES ARE TO BE COUPLED UNDER WORK SURFACE.
 - b. USB CONNECTIONS FOR MOUSE AND KEYBOARD ARE TO BE CONNECTED TO USB EXTENSION CABLES UNDER WORK SURFACE. USB CONNECTIONS FOR TABLE JACKS ARE TO BE CONNECTED TO A-B CABLES UNDER WORK SURFACE.
- G. CONNECTION BETWEEN CAMERA AND EQUIPMENT RACK IS MADE WITH AN AOC HDMI CABLE. TO REDUCE STRAIN, AOC CABLE IS TO BE COUPLED TO A STANDARD HDMI CABLE AT BOTH ENDS. COUPLER AND CABLES SHALL BE FASTENED SECURELY TO STRUCTURE OR EQUIPMENT RACK TO REDUCE STRAIN.
- H. ENABLE PHANTOM POWER FOR MIC 1 INPUT WITHIN CROSSPOINT SETTINGS.
- I. TAP SPEAKER AT 70V, 60W.
- J. NETWORK SWITCH IS CONFIGURED BY UNIVERSITY OF KENTUCKY IT SERVICES WITH MULTIPLE VLANs. SWITCH MUST BE CONNECTED IN ACCORDANCE WITH THIS SCHEMATIC IN ORDER FOR SYSTEM TO OPERATE PROPERLY.
- K. PROJECTION SCREEN TO BE HARD-WIRED TO BUILDING ELECTRICAL SYSTEM BY LICENSED ELECTRICIAN. SEE AV RACEWAY RISE DIAGRAM FOR FURTHER DETAILS.
- L. EQUIPMENT RACK TO BE BONDED TO BUILDING ELECTRICAL GROUND BY LICENSED ELECTRICIAN. MINIMUM 6AWG GREEN THHN REQUIRED.
- M. PROVIDE MOUNTS FOR ALL TVs OR PROJECTORS. MOUNTS TO BE INSTALLED BY GC IN ACCORDANCE TO UK GUIDELINES. AV CONTRACTOR IS NOT TO INSTALL MOUNTS.

UK DUAL PROJECTOR CLASSROOM



301 East Vine Street
Lexington, Kentucky 40507
859.252.6781

RESERVED FOR AHJ STAMP

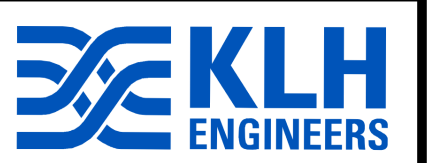

KOHR'S LONNEMANN HEIL
ENGINEERS, INC.
MECHANICAL/ELECTRICAL
ENGINEERS
WWW.KLHENGRS.COM

1538 ALEXANDRIA PIKE, SUITE 11
FT. THOMAS, KENTUCKY 41075
800-564-9783
859-442-8050
859-442-8058 FAX

BID DOCUMENTS
UK WT YOUNG LIBRARY - LOWER
LEVEL RENOVATION
UNIVERSITY OF KENTUCKY
LEXINGTON, KENTUCKY

TECHNOLOGY

PROJECT 202586
DATE 03.31.2026

REVISIONS		
No.	Description	Date
3	ADDENDUM 6	05/01/26

JRA ARCHITECTS HAS RETAINED AN ELECTRONIC VERSION OF THESE DRAWINGS. THE CLIENT AGREES NOT TO REUSE THESE DRAWINGS IN ELECTRONIC OR ANY OTHER FORMAT IN WHOLE OR IN PART FOR ANY PURPOSE OTHER THAN FOR THE PROJECT. THE CLIENT AGREES NOT TO TRANSFER THESE ELECTRONIC FILES TO OTHERS WITHOUT THE PRIOR WRITTEN CONSENT OF THE ARCHITECT. THE CLIENT FURTHER AGREES TO WAIVE ALL CLAIMS AGAINST THE ARCHITECT RESULTING IN ANY WAY FROM ANY UNAUTHORIZED CHANGES TO OR REUSE OF THE ELECTRONIC FILES FOR ANY OTHER PROJECT BY ANYONE OTHER THAN THE ARCHITECT.

TECHNOLOGY
AV SYSTEMS

T-643

COPYRIGHT 2025 - JRA, INC.

KLH PROJECT #: 27887