



UNIVERSITY OF KENTUCKY Purchasing Division

INVITATION FOR BIDS

CCK-2644-23

ADDENDUM # 2

8/30/2022

New Due Date – 9/22/2022

ATTENTION: This is not an order. Read all instructions, terms and conditions carefully.

IMPORTANT: BID AND ADDENDUM MUST BE RECEIVED BY 9/22/2022 @ 3:00 P.M. LEXINGTON, KY TIME

Bidder must acknowledge receipt of this and any addendum as stated in the Invitation for Bids.

This addendum is to inform potential bidders of the new schedule for this bid, as well as release the change in the Specifications with Drawings and Special Conditions, all are attached.

New Schedule:

Pre-Bid Meeting – September 8th at 10am - Nursing Bldg., NW Corner. 751 Rose Street, Lexington

Written Questions Due – September 13 by 4pm

Final Addendum posting - September 15

Bids Due by – September 22nd, no later than 3pm in a sealed envelope delivered to the Purchasing Bid Desk
322 Peterson Service Building
411 S. Limestone
Lexington, KY 40506

OFFICIAL APPROVAL
UNIVERSITY OF KENTUCKY

David D. Stefanic / Category Specialist / 859-257-5792

University of Kentucky
Purchasing Division
322 Peterson Service Building
Lexington, KY 40506-0005

01000S01- Special Conditions - General Contractor

UNIVERSITY OF KENTUCKY
SPECIAL CONDITIONS OF THE CONTRACT
FOR CONSTRUCTION BY A GENERAL CONTRACTOR
TABLE OF CONTENTS

ARTICLE 02 FIELD CONDITIONS	3
ARTICLE 03 (NOT USED)	3
ARTICLE 04 CONSULTANT	3
ARTICLE 05 GEOTECHNICAL REPORT	3
ARTICLE 06 TIME FOR COMPLETION	3
ARTICLE 07 LIQUIDATED DAMAGES	3
ARTICLE 08 SUBMITTALS AND SHOP DRAWINGS	3
ARTICLE 09 PLANS, DRAWINGS, AND SPECIFICATIONS	6
ARTICLE 10 PROGRESS MEETINGS	7
ARTICLE 11 CONSTRUCTION SCHEDULE – BAR CHART	7
ARTICLE 12 WALK-THROUGH	9
ARTICLE 13 OWNER’S CONSTRUCTION REPRESENTATIVE (NOT USED)	10
ARTICLE 14 FIELD OFFICE	10
ARTICLE 15 TELEPHONE SERVICE (NOT USED)	10
ARTICLE 16 CONSTRUCTION FENCE	10
ARTICLE 17 PROJECT SIGN	11
ARTICLE 18 PARKING	11
ARTICLE 19 SANITARY FACILITIES	11
ARTICLE 20 RULES OF MEASUREMENT	11
ARTICLE 21 ALLOWANCES (NOT USED)	11
ARTICLE 22 SEQUENCE OF CONSTRUCTION	11
ARTICLE 23 CRANE & MATERIAL HOIST OPERATIONS	12
ARTICLE 24 UTILITIES	12
ARTICLE 25 CLEANING AND TRASH REMOVAL	13
ARTICLE 26 BLASTING	13
ARTICLE 27 CUTTING AND PATCHING - NEW AND EXISTING WORK	14
ARTICLE 28 UNRELATED PROJECTS	14
ARTICLE 29 OWNER SUPPLIED MATERIALS (NOT USED)	14
ARTICLE 30 REMOVED ITEMS (NOT USED)	14
ARTICLE 31 INTERIOR ENCLOSURE AND DUST ENCAPSULATION (NOT USED)	14
ARTICLE 32 UKIT COMMUNICATIONS AND NETWORK SYSTEMS (NOT USED)	14
ARTICLE 33 EMERGENCY VEHICLE ACCESS	14
ARTICLE 34 SMOKE DETECTORS / FIRE ALARM SYSTEMS- EXISTING AND/OR NEW FACILITIES (NOT USED)	14
ARTICLE 35 SURVEYS, RECORDS, AND REPORTS	14
ARTICLE 36 TOBACCO PRODUCTS PROHIBITED	15
ARTICLE 37 ALTERNATES (NOT USED)	15
ARTICLE 38 FIELD CONSTRUCTED MOCKUPS (NOT USED)	15
ARTICLE 39 PROJECT COORDINATION VIA COMPUTER	15
ARTICLE 40 HOT WORK PERMITS	16
ARTICLE 41 INSURANCE	16
ARTICLE 42 KEY ACCESS (NOT USED)	16
ARTICLE 43 CEILING CLEARANCE (NOT USED)	16
ARTICLE 44 METAL ANCHORS	16
ARTICLE 45 CONTRACTOR/SUPERINTENDENT EXPERIENCE (NOT USED)	17
ARTICLE 46 LOADING DOCK (NOT USED)	17
ARTICLE 47 CONSTRUCTION PATH (NOT USED)	17
ARTICLE 48 HOSPITAL PROJECT PROCEDURE (NOT USED)	17
ARTICLE 49 WORKING HOURS/ACCESS: FOR MEDICAL CENTER/HOSPITAL (NOT USED)	17
ARTICLE 50 SECURITY BADGES AND MEDICAL CENTER SECURITY (NOT USED)	17

010000S01- Special Conditions - General Contractor

ARTICLE 51 HOSPITAL CONSTRUCTION CERTIFICATION (NOT USED)	17
ARTICLE 52 APPEARANCE (NOT USED)	17
ARTICLE 53 HIPAA (THE HEALTH INSURANCE PORTABILITY AND ACCOUNTABILITY ACT) (NOT USED)	17
ARTICLE 54 SAFETY & FIRE PROCEDURES (NOT USED)	17
ARTICLE 55 INTERIM LIFE SAFETY MEASURES (ILSM) (NOT USED)	17
ARTICLE 56 TREE PROTECTION STANDARDS	17

010000S01- Special Conditions - General Contractor

ARTICLE 01 GENERAL INFORMATION

1.1 These Special Conditions are intended to modify, supplement, or delete from, applicable Articles of the General Conditions.

1.2 Where any Article of the General Conditions is supplemented by these Special Conditions, the Article shall remain in effect and the supplement shall be added thereto.

1.3 Where Special Conditions conflict with General Conditions, provisions of the Special Conditions take precedence.

ARTICLE 02 FIELD CONDITIONS

2.1 General Contractor will secure all data at the site of the building such as grades of lot, convenience of receiving and sorting material, location of public services, and other information which will have a bearing proposals or on the execution of the Work and shall address these issues in the preparation of their bid. No allowance shall be made for failure of the General Contractor to obtain such site information prior to submitting their proposal, and no adjustment to the General Contractor's Contract amount or stipulated time for completion shall be allowed when due to failure by the General Contractor to do so.

ARTICLE 03 (NOT USED)

ARTICLE 04 CONSULTANT

4.1 Wherever in these Contract Documents reference is made to the Consultant, it shall be understood to mean Brown & Kubican or their duly authorized representatives. (See Article 2 of the General Conditions.)

ARTICLE 05 GEOTECHNICAL REPORT

5.1 No subsurface or geotechnical survey information is available at this time.

ARTICLE 06 TIME FOR COMPLETION

6.1 The time for Substantial Completion as further defined in Article 1 of the General Conditions shall be thirty (30) consecutive calendar days from the date of commencement as specified in the Work Order letter, and Final Completion shall be thirty (30) days thereafter.

ARTICLE 07 LIQUIDATED DAMAGES

7.1 Should the General Contractor fail to achieve Substantial Completion of the Work under this Contract on or before the date stipulated for Substantial Completion (or such later date as may result from extensions in the Contract Time granted by the Owner), he agrees that the Owner is entitled to, and shall pay the Owner as liquidated damages the sum of \$ Two Hundred Fifty Dollars (\$250.00) for each consecutive calendar day that Substantial Completion has not been met. See Article 3 of the Agreement.

7.2 Should the General Contractor fail to achieve Final Completion of the Work under this Contract on or before the date stipulated for Final Completion (or such later date as may result from extensions in the Contract Time granted by the Owner), he agrees that the Owner is entitled to, and shall pay the Owner as liquidated damages the sum of \$ One Hundred Dollars (\$100.00) for each consecutive calendar day until Final Completion is reached. See Article 3 of the Agreement.

ARTICLE 08 SUBMITTALS AND SHOP DRAWINGS

8.1 SUBMISSIONS - GENERAL

010000S01- Special Conditions - General Contractor

8.1.1 The General Contractor shall submit each set of Shop Drawings, product data, samples, and test and/or certification reports as a separate item in UK E-Communication®. Projects not utilizing UK E-Communication® must submit all items electronically to the Consultant and the UK Project Manager and Administrative Coordinator.

8.1.2 All sample selections for color shall be submitted for approval at the same time. Color selections shall not be submitted individually.

8.1.3 Any deviation from the Contract Documents shall be noted on the transmittal form comment section.

8.1.4 All submittals are to be reviewed by the General Contractor for compliance with the Contract Documents before submission for approval. All submittals are to be initiated by the General Contractor. Submittals made directly to the Consultant by sub-contractors, manufacturers or suppliers will not be accepted or reviewed.

8.1.5 Re-submittals shall conspicuously note all changes from earlier submissions. Special notation by the General Contractor shall be made to any changes other than those in response to the Consultant's review.

8.1.6 Manufacturers shall, when requested by the Consultant, submit test reports prepared by reputable firms or laboratories certifying as to performance, operation, construction, wearability, etc., to support claims made by the manufacturer of the equipment or materials proposed for inclusion in the Work. General Contractor shall also submit a list of three (3) installations where said equipment or materials have been in service for a minimum of five (5) years.

8.2 SUBMISSIONS - REVIEW

8.2.1 Review of submittals is only for compliance with the design concept and the contract documents. **THE CONSULTANT SHALL NOT BE RESPONSIBLE FOR CHECKING DEVIATIONS FROM CONTRACT DOCUMENT REQUIREMENTS OR CHANGES FROM EARLIER SUBMISSIONS NOT SPECIFICALLY NOTED.**

8.2.2 The following shall be verified prior to making submittals:

Field Measurements, Field Construction Criteria, Catalog numbers and similar data, Quantities and Capacities, and Compliance with requirements, including verification of all dimensions,

8.2.3 Review Stamp designations shall be as follows:

8.2.3.1 "NET = No Exceptions Taken" : Proceed with the Work, no corrections needed.

8.2.3.2 "FC= Furnish as Corrected": Proceed with the Work, noting the corrections/conditions of the approval.

8.2.3.3 "RR = Revise and Resubmit": Do not proceed with the Work, as the submittal does not comply with the Contract Documents. Revisions to the submittal are required for approval. On projects utilizing UK E-Communication, "Send Back a Step" is used in lieu of "Revise and Resubmit"

8.2.3.4 "R = Rejected": Do not proceed with the Work, the submittal is rejected.

8.3 SUBMISSIONS - SPECIAL PROVISIONS

8.3.1 In making a submittal, the General Contractor shall be deemed to be making the following representations:

010000S01- Special Conditions - General Contractor

8.3.1.1 The General Contractor understands and agrees that he shall bear full responsibility for the products furnished. The General Contractor expressly warrants that products described in the attached submittal will be usable and that they conform to the Contract requirements unless specifically noted otherwise.

8.3.1.2 The General Contractor understands and agrees that, without assuming design responsibility, he expressly warrants that products described in the attached submittal are capable of being used in accordance with the intent of the design documents and that they conform to the Contract requirements unless specifically noted otherwise.

8.3.1.3 The General Contractor acknowledges that the Owner will rely on the skill, judgment, and integrity of the General Contractor as to conformance requirements and subsequent usability.

8.4 SHOP DRAWING AND PROCUREMENT SUBMITTAL LOG

8.4.1 The General Contractor, within ten (10) days after the Pre-Construction meeting, shall begin uploading submittals using UK E-Communication[®], to generate a log fixing the dates for submission of Shop Drawings, special order material items, certifications, guarantees, and any other items required to be submitted to the Consultant for review, approval or acceptance. Projects not utilizing UK E-Communication[®] will submit a Shop Drawing Log provided by the Owner during the Pre-Construction Meeting.

8.4.2 The log shall track all submittals to date. The updated log shall then be reviewed and discussed at each progress meeting to determine items that may impact the construction schedule.

8.5 Shop Drawings

8.5.1 The General Contractor shall review, approve, and submit Shop Drawings to the Consultant, in accordance with the Consultant's Shop Drawing & Procurement Submittal Log or UK E-Communication[®], as herein detailed. By approving and submitting Shop Drawings, the General Contractor represents that he has determined and verified all materials, field measurements, and field construction criteria related thereto, or will do so, and that he has checked and coordinated the information contained within such submittals with the requirements of the Work and of the Contract Documents.

8.5.2 The General Contractor shall submit Shop Drawings required for the Work and the Consultant will review and take appropriate action. The review and approval shall be only for conformance with the design concept of the Project and for compliance with the information given in the Contract Documents. The approval of a separate item will not indicate approval of the assembly in which the item functions.

8.5.3 The General Contractor shall make any corrections required by the Consultant for compliance to the Contract and shall return the required number of corrected copies of Shop Drawings and resubmit new samples until approved. The General Contractor shall direct specific attention, in writing, or on resubmitted Shop Drawings, to revisions other than the corrections called for by the Consultant on previous submissions. The General Contractor's stamp of approval on any shop drawing or sample shall constitute a representation to Owner and Design Consultant that the General Contractor has either determined and verified all quantities, dimensions, field construction criteria, materials, catalog numbers, and similar date, or he assumes full responsibility for doing so, and that he has reviewed or coordinated each shop drawing or sample with the requirements of the Work and the Contract Documents.

8.5.4 Where a shop drawing or sample submission is required by the specifications, no related Work shall be commenced until the submission has been approved by the Design Consultant. A copy of each approved shop drawing and each approved sample shall be kept in good order by the General Contractor at the site and shall be available to the Consultant.

010000S01- Special Conditions - General Contractor

8.5.5 The Consultant's approval of Shop Drawings or samples shall not relieve the General Contractor from his responsibility for any deviations from the requirements of the Contract Documents unless the General Contractor has in writing called the Consultant's attention to such deviation at the time of submission and the Consultant has given written approval to the specific deviation. Any approval by the Consultant shall not relieve the General Contractor from responsibility for errors or omissions in the Shop Drawings.

8.5.6 All submittals are to be submitted electronically by the contractor. Shop Drawings submitted through UK E-Communication® shall be scanned and submitted in color. Mark-ups must be made using visible color when printed. Workflow in UK E-Communication® will be established during the workflow meeting. Each individual Shop Drawing shall have its respective specification number and description highlighted.

8.5.7 Where Shop Drawings include fire alarm, communication systems schematics, sprinkler systems, etc., a sepia of each drawing shall be submitted to the Consultant as part of the "Record" set of drawings.

8.6 SUBMISSIONS – SAMPLES (NOT USED)

8.7 SUBMISSIONS - OPERATION AND MAINTENANCE MANUALS (NOT USED)

8.8 SUBMISSIONS – AS - BUILT SET OF DRAWINGS

8.8.1 The General Contractor shall submit one (1) electronic copy of As - Built set of drawings in .pdf format indicating all deviations of construction as originally specified in the Contract Documents. These As-Built Drawings will compile information from the General Contractor as well as all Sub-contractors. The General Contractor shall provide a qualified representative to update the As - Built set of drawings as construction progresses. As-Built submitted through UK E-Communication® shall be scanned and submitted in color. Mark-ups must be made using visible color when printed

8.8.2 The General Contractor shall provide and utilize a camera to photograph the installation of buried utilities and concealed items. The General Contractor shall provide standard 3 1/2" x 5" photographs with negatives, or digital images (.jpeg format), which shall be submitted as part of the Operation and Maintenance Manuals submission. These photos should be mounted in a bound album with labeling as to subject of photo, date, and Project. Such album is to be kept at job site with the As - Built set of drawings until submittal of same.

8.8.3 Approval of the Final Payment request will be contingent upon compliance with these provisions. The General Contractor's As – Built set of drawings shall be delivered to the Consultant at their completion so that the Consultant may make any changes on the original contract drawings.

8.9 SUBMISSIONS - SAP EQUIPMENT LIST (NOT USED)

8.10 SUBMISSIONS – MAINTENANCE MATERIALS

8.10.1 If specified, Maintenance/Replacement Materials, Spare Parts, and special maintenance tools for proper maintenance shall be provided by the General Contractor.

ARTICLE 09 PLANS, DRAWINGS, AND SPECIFICATIONS

9.1 The successful General Contractor can purchase any number of sets of plans and specifications from Lynn Imaging, Lexington, Kentucky (<http://www.ukplanroom.com/> or phone Lynn Imaging @ 1.800.888.0693 or 859.255.1021). The General Contractor will be required to pay Lynn Imaging for the cost of duplication for all sets required.

010000S01- Special Conditions - General Contractor

9.2 The University will provide two (2) sets of the 'Official Contract Documents' book to the successful General Contractor. One (1) set is to be for his office and the other set is for the jobsite.

9.3 All drawings, specifications and copies thereof, prepared by the Consultant, are the property of the University of Kentucky. They are not to be used on other Work.

ARTICLE 10 PROGRESS MEETINGS

10.1 In addition to specific coordination and pre-installation meetings for each element of Work, and other regular Project meetings held for other purposes, progress meetings will be held as outlined at the Preconstruction Meeting. Each entity then involved in planning, coordination or performance of Work shall be properly represented at each progress meeting. The following areas will be covered at each progress meeting: current status of work in place, General Contractor's review of upcoming work (1 month look ahead), schedule status, upcoming outages, new outage requests, shop drawings due from contractors, shop drawings being reviewed, outstanding RFI's, outstanding proposed change orders, change orders, new business, As-Built updated, close-out documents status, defective work in place issues, review "pencil copy" of payment application, safety issues and new business or other issues not covered above. With regard to schedule status, discuss whether each element of current work is ahead of schedule, on time, or behind schedule in relation with updated progress schedule; determine how behind-schedule Work will be expedited, and secure commitments from entities involved in doing so; discuss whether schedule revisions are required to ensure that current Work and subsequent Work will be completed within Contract Time; and review everything of significance which could affect the progress of the Work.

10.2 General Contractor shall prepare and submit at each progress meeting an updated schedule indicating Work completed to date and any needed revisions.

10.3 With the express purpose of expediting construction and providing the opportunity for cooperation of affected parties, progress meetings will be held and attended by representatives of:

- (1) The Owner's Project Manager
- (2) The Consultant.
- (3) General Contractor.
- (4) Sub-contractors.
- (5) Others requested to attend (as deemed necessary by CPMD).
- (6) Physical Plant Division Representative

10.4 A location near the site will be designated where such progress meetings will be held. Participants will be notified of the dates and times of the meetings by the Consultant.

ARTICLE 11 CONSTRUCTION SCHEDULE – BAR CHART

11.1 The General Contractor shall prepare construction schedules as a bar chart, with separate divisions for each major portion of the work, and in sufficient detail to identify the plan and sequence of construction to be followed in meeting the requirements of the Contract. Schedules shall include divisions for Work to be accomplished remote from the central construction site, e.g. utilities from outside the construction site to the site for chilled water, steam, electrical, communications, and/or fire service. Such Work shall be scheduled so that disruption resulting from construction will be minimized. Start dates and completion dates for such Work must be maintained and completed in the shortest reasonable time. The sequence of listings shall follow the Table of Contents of the Specifications. Maximum sheet size shall be 30" x 42". The schedule shall show the complete sequence of construction, by activity, with dates for beginning and completion of each element of the Work.

11.1.1 For projects requiring a bar chart schedule instead of a Critical Path Method (CPM) schedule, the following Articles of the General Conditions are amended as follows:

11.1.2 Article 21.4.2 of the General Conditions to the Contract is amended to read as follows:

010000S01- Special Conditions - General Contractor

- 21.4.2 Requests for an extension of time due to unusually bad weather shall be considered for approval only if it is shown that a) the unusual weather event delayed work on a specific weather sensitive activity or activities that had been planned to be underway on the date(s) on which the weather event occurred, as shown in the most recent update to the Project schedule that had been submitted to the Owner prior to the date of the event and b) that the delay to that activity or activities is shown to be the proximate cause of a corresponding delay to the contractually required completion dates for the Project that were shown in the most recent update to the Project schedule. The actual dates on which the delay(s) occurred must be stated and the specific activities that were directly impacted must be identified. In the event of concurrent delays, only those activities actually impacting the Project contractually required completion dates will be considered in evaluating the merit of a delay request and in adjusting the schedule. Time extensions will not be considered for concurrent delays not caused by the Owner. Requests for an extension of time which are not supported by this information shall not be considered for approval by the Owner.
- 11.1.3 Article 21.4.3 of the General Conditions to the Contract is amended to read as follows:
- 21.4.3 In anticipation of the possibility of delay due to unusual bad weather, the General Contractor shall identify those activities in the schedules, and those activities subsequently added to updated schedules, that might reasonably be expected to be delayed by bad weather.
- 11.1.4 Article 21.7 of the General Conditions to the Contract is amended to read as follows:
- 21.7 The Contract Time will only be adjusted for causes specified above. Extensions of time will only be approved if the General Contractor can provide justification supported by the Project schedule or other acceptable data that such changes extend the contractually required date of Substantial Completion, and that the General Contractor has expended all reasonable effort to minimize the impact of such changes on the construction schedule. No additional extension of time will be granted subsequently for claims having the basis in previously approved extensions of time.
- 11.1.5 Article 21.8 of the General Conditions to the Contract is amended to read as follows:
- 21.8 In support of requests for an extension of time not caused by unusual inclement weather, and concurrently with the submittal of any such request, the General Contractor shall submit to the Consultant and the Owner a written impact analysis showing the influence of each such event on contractually required completion dates as shown in the updated Project schedule most recently submitted to the Owner prior to the event. The analysis shall include the sequence of new or revised activities and/or durations that are proposed to be added to the existing schedule including related logic. This impact analysis shall include the new activities and/or activity revisions proposed to be added to the existing schedule and shall demonstrate the claimed impact on the contractually required completion dates. The General Contractor will not be granted an extension of time and/or relief from liquidated damages when the delay to completion of the work is attributable to, within the control of, or due to the fault, negligence, acts, or omissions of the General Contractor and/or the General Contractor's contractors, subcontractors, suppliers, or their respective employees and agents. Time extensions will not be considered for concurrent delays not caused by the Owner. In the event of concurrent delays, only that event actually impacting contractually required completion dates will be considered in adjusting the schedule and evaluating the merit of a delay claim. Requests for an extension of time which are not supported by this information shall not be considered for approval.
- 11.1.6 Article 32.1 of the General Conditions to the Contract is amended to read as follows:
- 32.1 The General Contractor shall prepare and submit to the Owner and the Consultant a bar-chart type construction schedule for the Work. The schedules shall include all activities necessary for performance of the work showing the duration and the planned start and finish dates for each activity. The schedules shall include, but not be limited to, submittal processing, fabrication and delivery of materials, construction, testing, clean-up, work and/or materials to be

010000S01- Special Conditions - General Contractor

provided by the Owner, dates and durations for major utility outages requiring coordination with the Owner and the Owner's operations, and significant milestones related to the completion of the Project.

11.2 The schedule shall be submitted to the Consultant and to the Owner for review within thirty (30) calendar days after the date established for the start of Work on the Project as stated in the official Work Order and Notice to Proceed. Review will be only for general conformance to the requirements of the contract. Review comments and/or acceptance of the Contractor's schedule shall not relieve the Contractor of any obligation for compliance with all requirements of the Contract Documents. Such review and comments shall not constitute interference with the Contractor's means and methods of construction, which shall remain solely the responsibility of the Contractor.

11.3 Schedules shall be revised no less frequently than monthly to coincide with regular monthly Project progress meetings and submission of Applications for Payment and shall be updated to indicate progress of each activity to the date of submittal, the projected completion of each activity, any activities modified since previous submittal, any major changes in scope, and all other identifiable changes, and further shall be accompanied by a narrative report to define problem areas, anticipated delays, impact on the progress of the Work, and to report corrective action taken or proposed.

11.4 Initial schedules shall be submitted within thirty (30) calendar days after the date established in Notice to Proceed. After review, required revisions to the schedule shall be completed and incorporated in the schedule within ten (10) calendar days. Up-dated Progress Schedules shall be submitted with each Application for Payment. Submissions must include one (1) opaque reproduction and one (1) electronic copy (disk or CD) along with a transmittal letter.

11.5 Copies of reviewed Schedules are to be provided to the job site file and, as appropriate, to sub-contractors, suppliers, and other concerned entities, including separate contractors. Recipients are to be instructed to promptly report, in writing, problems anticipated by projections shown in schedules.

11.6 The processing of all progress payments is contingent upon the submission of updated schedules.

11.7 The processing of all Change Orders requesting a time extension to the contract are contingent upon the submission and approval of a revised schedule demonstrating that the change order does impact the date of completion for the entire project. Time extension requests associated with Change Orders that do not impact the date of completion for the entire project will be rejected.

ARTICLE 12 WALK-THROUGH

12.1 After the "Work Order" is issued but before Work by the General Contractor is started, a walk-through of the area is required to document the condition of the space, surfaces, or equipment. It is the responsibility of the General Contractor to schedule the walk-through with the Owner's Project Manager, the Consultant, and other interested parties.

12.2 During the walk-through, General Contractor shall identify all damaged surfaces or other defective items that exist prior to construction.

12.3 The walk-through shall be attended by Owner's Project Manager, a Representative of the user of the facility, the General Contractor and the Consultant

12.4 Written documentation of the walk-through is to be provided by the Consultant with copies distributed to all parties. Polaroid type color photographs are to be provided and labeled by General Contractor and one (1) copy of such photographs are to be given to Consultant. (Digital photos in a .jpg format are acceptable if submitted on digital media storage) All parties attending the walk-through agree on the list of damages.

010000S01- Special Conditions - General Contractor

ARTICLE 13 OWNER'S CONSTRUCTION REPRESENTATIVE (NOT USED)

ARTICLE 14 FIELD OFFICE

14.1 General Contractor shall make his own provision for field office for his own personnel and for incidental use by their Sub-contractors. Quantity and location are subject to approval of the Consultant and the Owner's Project Manager.

14.2 A field office shall not be required for this Project.

ARTICLE 15 TELEPHONE SERVICE (NOT USED)

ARTICLE 16 CONSTRUCTION FENCE

16.1 Construction fencing will be designed and erected around job sites where there is a possibility of injury to employees, students or the public. Special precautions must be taken to protect the visually impaired, disabled, children and others using the University facilities. During active excavation/trenching operations, fencing shall be erected to prevent unauthorized entry into the site. All fencing shall comply with the current requirements of the International Building Code except where the following requirements are more stringent.

16.1.1 All job site perimeter fencing within 5 feet of a walkway, street, plot line, or public right-of-way shall be 8 feet in height. Perimeter fencing that blocks sidewalks must include signs directing pedestrians to a safe walkway or crosswalk. Signage may be attached to the fence, but may also be required to inform pedestrians of sidewalk closures and detours prior to arriving at the closed area. General Contractor shall provide electrical pedestrian and general lighting along the top rail of the perimeter of the construction site fence to provide a minimum illumination level of 1.5 foot candles. Pedestrian and perimeter fence lighting shall be installed in conduit, raceway, and/or pathway system properly supported to the perimeter fence. Open or flexible cabling will not be acceptable.

16.1.2 All job site perimeter fencing more than 5 feet from a walkway, street, plot line, or public right-of-way shall be a minimum of 6 feet in height unless International Building Code requirements are more restrictive due to the height of the structure and setback.

16.1.3 All fencing shall be of a woven material such as chain link or a solid type fence. Fencing shall include gates required for construction operations. Gates shall be lockable with both the General Contractor's lock, and a lock provided by the Owner. Lock by Owner shall be keyed for the University Best GA key core. All locks to be "daisy-chained" to provide access to the Owner.

16.1.4 It shall be the General Contractor's responsibility to determine the proper quality of materials and methods of installation of the fencing, with the understanding that it must be maintained in good condition, good appearance, rigid, plumb, and safe throughout the construction period. The fence does not have to be new material. The fence is to be erected on fence posts securely anchored in the ground. Provide a top bar or, with prior approval of the owner, a wire shall be run through the top of the fence and attached to the end posts. A tension control device shall be installed as necessary. Use of sandbags, concrete weights, stakes, etc. to hold fence posts in place are not allowed. Penetrations in pavement or landscape walking surfaces may not be made without the approval of the owner. Any damage caused by the fence installation shall be repaired in a manner satisfactory to the owner. When fencing is to remain in place for six (6) months or more a green fabric mesh must be provided for the full height and length of the fence. Fabric should be omitted for one (1) section of fencing where blind corners occur or at pedestrian/vehicle intersections.

16.1.5 The General Contractor shall be responsible for removing and replacing any fence sections and/or posts necessary for access to the site on a daily basis. The General Contractor shall police such conditions to assure the fence and posts are reset in a timely manner and are specifically in place at the close of the working day.

010000S01- Special Conditions - General Contractor

16.1.6 If the General Contractor fails to comply with the requirements of this Article 16, the Owner may proceed to have the work done and the General Contractor shall be charged for the cost of the Work done by unilateral deductive change order.

16.1.7 Plastic construction fencing is not acceptable as a perimeter protection fence.

ARTICLE 17 PROJECT SIGN

17.1 No signs, except those attached to vehicles or equipment, may be displayed without permission from the Consultant and the Owner's Project Manager. No political signs will be permitted.

ARTICLE 18 PARKING

18.1 The University of Kentucky will make available for purchase by the General Contractor up to four (4) parking permits. The category of parking permit and location of parking is determined by the Director, Parking and Transportation Services, or a designee. Parking permits may be purchased by the General Contractor to be used by the Contractor and/or the Contractor's subcontractors and employees during the construction period. The cost of each permit is based on the pro-rata annual cost and may be purchased from Parking Services, 721 Press Avenue, after the Contract is executed. Necessary documents required to purchase the passes will be available at the Pre-Construction Conference.

18.2 The Director, Parking and Transportation Services, or a designee will determine if parking is available for employees of the Contractor and subcontractors in the K lots at Commonwealth Stadium or elsewhere on Campus. The Contractor will be given thirty (30) days notice should conditions change that will affect parking at the designated parking area and it is necessary to relocate parking or terminate parking privileges. If parking is available, permits may be purchased from Parking Services, 721 Press Avenue at the appropriate monthly cost.

ARTICLE 19 SANITARY FACILITIES

19.1 Restroom facilities in one of the surrounding buildings will be designated at the Pre-Construction Meeting for use by the General Contractor's workforce during construction. The designated restroom(s) and areas accessible to General Contractor must be kept clean and neat during construction. Failure to keep them clean will result in the General Contractor being required to provide portable toilets at his cost at the site. Drinking water shall be provided from an approved safe source so piped or transported as to be kept clean and fresh and served from single service containers or satisfactory types of sanitary drinking stands or fountains. All such facilities and services shall be furnished in strict accordance with existing governing health regulations.

ARTICLE 20 RULES OF MEASUREMENT

20.1 Rules of Measurement shall be established by the Consultant in the field. Actual measurement shall be taken in the field. These amounts shall become binding upon the General Contractor and be adjusted as before mentioned.

20.2 The General Contractor shall pay for and coordinate through the Consultant and/or the Owner's Project Manager all associated Work by utility companies including relocation of utility poles, installation of new street lights, relocation of overhead or underground lines, and any other Work called for on the Plans and in the Specifications.

ARTICLE 21 ALLOWANCES (NOT USED)

ARTICLE 22 SEQUENCE OF CONSTRUCTION

22.1 NOT USED.

010000S01- Special Conditions - General Contractor

22.2 All materials and equipment are to be brought into the project site from the approved staging location and are not to be brought through the existing buildings or loading docks. Any and **all** exceptions shall be approved by, and closely coordinated with, the Owner's Project Manager in advance of scheduling or performing the work.

22.2.1 The General Contractor shall coordinate any road and sidewalk closings, utility disruptions, etc. which will affect the use of the existing building(s) with the Owner's Project Manager prior to commencing that Work.

22.3 The adjacent buildings and public areas will remain in use and the Owner shall have access to the existing building(s) throughout the duration of the Project. The General Contractor shall coordinate construction activity to assure the safety of those who must cross the Project site and shall provide and maintain the necessary barriers and accommodations for a completely safe route of accessibility. The General Contractor is to insure that all exits provide for free and unobstructed egress. If exits must be blocked, prior arrangements must be made with the Owner's Project Manager.

22.4 The General Contractor shall cooperate with the Owner to minimize inconvenience to, or interference with normal use of existing buildings and grounds by staff, students, other Contractors, or the public. General Contractor shall conduct operations to prevent damage to adjacent building structures and other facilities and in such a manner to protect the safety of building's occupants.

ARTICLE 23 CRANE & MATERIAL HOIST OPERATIONS

23.1 General Contractor shall provide appropriate barriers around crane and material hoist to protect pedestrian-and vehicular traffic around operating area. When crane is operating or moving, flag men provided by General Contractor shall be utilized to prevent pedestrian and vehicular traffic from crossing the pathway of crane lift. General Contractor's flag men shall coordinate these activities with the appropriate security personnel.

23.2 Cranes and material hoists shall be safely secured and inaccessible during non-operating hours. General Contractor shall coordinate operation or erection of a crane or material hoist in the vicinity of the Medical Center with Medical Center Aeromedical Operations (Med-evac helicopter).

23.3 Any damage to trees, shrubs or plant material at the placement of crane or material hoist shall be repaired by tree surgery or replaced as directed by Consultant.

ARTICLE 24 UTILITIES

24.1 This Article modifies Article 8 of the General Conditions. The Owner will provide water and electricity for this Project. The General Contractor shall provide for all temporary taps, hoses, lines, boxes, lighting and installation of the same for construction operations. Electricity shall not be used for heating purposes. In the event that the General Contractor is wasteful with these utilities, the Owner shall charge the General Contractor accordingly.

24.2 UTILITY OUTAGES

24.2.1 Interruption of Utilities and Services: No utilities or services may be interrupted without full consent and prior scheduling of the Owner. Owner approval is required in writing for each disruption.

24.2.1.1 ENTIRE BUILDING OUTAGE

The Owner's Project Manager is the General Contractor's contact with the University for requesting Utility Outages. The Owner's Project Manager will contact the proper departments and divisions within the University and receive approval from those units prior to allowing a planned outage to occur. The established standard within the University Departments and Divisions of an entire building or

010000S01- Special Conditions - General Contractor

group of buildings shall be three weeks written notice. The written notice shall include the type of utility to be interrupted, reason for outage, length of outage, what will be affected by the outage and a statement of whether or not the materials are on hand to complete the Work. If a specific time is desired for the outage it should be included. The Owner's Project Manager will insure that all parties affected are contacted and that a time which is least disruptive to all parties is selected. At the appointed outage time, Work shall begin and proceed continuously with all required manpower until Work is complete at no added cost to the University. The Owner's Project Manager will then notify all affected departments or divisions.

24.2.1.2 SECTION OF A BUILDING OUTAGE

The Owner's Project Manager is the General Contractor's contact with the University for requesting Utility Outages. The Owner's Project Manager will contact the proper departments and divisions within the University and receive approval from those units prior to allowing a planned outage to occur. The established standard within the University Departments and Divisions of a section of a building shall be a written request one week prior to outage. The written request shall include the type of utility to be interrupted, when the outage is desired, reason for outage, length of outage, and what will be affected by the outage. The Owner's Project Manager will insure that all parties affected are contacted and that a time which is least disruptive to all parties is selected. At the appointed outage time Work shall begin and proceed continuously with all required manpower until Work is complete at no added cost to the University. The Owner's Project Manager will then notify all affected departments or divisions.

ARTICLE 25 CLEANING AND TRASH REMOVAL

25.1 The General Contractor shall keep clean the entire area of new construction and shall keep streets used as access to and from the site free of mud and debris.

25.2 All exit ways, walks, drives, grass areas, and landscaping must be kept free from debris, materials, tools and vehicles at all times. Trim weeds and grass within the site area.

25.3 Upon completion of the Work, General Contractor shall thoroughly clean and re-sod grass areas damaged to match existing areas.

25.4 The General Contractor shall be responsible for removal from the site of all liquid waste or other waste (i.e. hazardous, toxic, etc.) that requires special handling on a daily basis.

25.5 Dumpsters will be provided and maintained by the General Contractor.

25.6 During Work at the Project site, the General Contractor shall clean and protect Work in progress and adjoining Work on a continuing basis. General Contractor shall apply suitable protective covering on newly installed Work where needed to prevent damage or deterioration until the time of Substantial Completion. General Contractor shall clean and perform maintenance on newly installed Work as frequently as necessary through remainder of construction period.

25.7 The General Contractor shall be responsible for daily cleaning of spillage's and debris resulting from his and his Sub-contractor's operations, (includes removal of dust and debris from wall cavities), and for providing closed, tight fitting (dustproof if required), waste receptacles to transport construction debris from the work area to the dumpster. Broom clean all floors no less than once a week. The General Contractor shall empty such receptacles into the trash container when full or when directed to be emptied by the Consultant and/or Owner's Project Manager, but not less than weekly. The use of hospital waste and trash receptacles is strictly prohibited, except as otherwise provided by the project specifications.

25.8 Failure to comply with the above requirements shall be cause for stopping work until the condition is corrected.

ARTICLE 26 BLASTING

010000S01- Special Conditions - General Contractor

26.1 There shall be no blasting under any conditions on University of Kentucky property unless specified in these Special Conditions.

ARTICLE 27 CUTTING AND PATCHING - NEW AND EXISTING WORK

27.1 New Work - Cutting and patching shall be done by craftsmen skilled and experienced in the trade or craft that installed or furnished the original Work. Repairs shall be equal in quality and appearance to similar adjacent Work and shall not be obviously apparent as a patch or repair. Work that cannot be satisfactorily repaired shall be removed and replaced.

27.2 Existing Construction - Refer to Architectural, Mechanical, and Electrical drawings for cutting and patching. All new Work shall be connected to the existing construction in a neat and workmanlike manner, presenting a minimum of contrast between old and new Work. Do all patching of the existing construction as may be required for the new construction to be done. Necessary patching, closing of existing openings, repairing and touching up shall be included as required for a proper, neat and workmanlike finished appearance. Any existing item that is to remain and is damaged during construction shall be replaced at the General Contractor's expense.

ARTICLE 28 UNRELATED PROJECTS

28.1 Unrelated construction Projects may be under way in the vicinity of this Project or the site utility work during the course of the Work related to this Project. The General Contractor for this Project must coordinate with any other contractors regarding overlapping areas. See Article 42 - Separate Contracts of the General Conditions.

ARTICLE 29 OWNER SUPPLIED MATERIALS (NOT USED)

ARTICLE 30 REMOVED ITEMS (NOT USED)

ARTICLE 31 INTERIOR ENCLOSURE AND DUST ENCAPSULATION (NOT USED)

ARTICLE 32 UKIT COMMUNICATIONS AND NETWORK SYSTEMS (NOT USED)

ARTICLE 33 EMERGENCY VEHICLE ACCESS

33.1 Emergency Vehicle Access must be maintained during construction. The General Contractor shall coordinate with the local Fire and Emergency Medical Services department(s) that would respond to an emergency during the initial start up of construction to ensure a complete understanding of their requirements.

ARTICLE 34 SMOKE DETECTORS / FIRE ALARM SYSTEMS- EXISTING AND/OR NEW FACILITIES (NOT USED)

ARTICLE 35 SURVEYS, RECORDS, and REPORTS

35.1 General: Working from lines and levels established by property survey, and as shown in relation to the Work, the General Contractor will establish and maintain bench marks and other dependable markers to set lines and levels for Work at each area of construction and elsewhere on site as needed to properly locate each element of the entire Project. The General Contractor shall calculate and measure from the bench marks and dependable markers required dimensions as shown (within recognized tolerances if not otherwise indicated), and shall not scale drawings to determine dimensions. General Contractor shall advise Sub-contractors performing Work of marked lines and levels provided for their use in layout of Work.

010000S01- Special Conditions - General Contractor

35.2 Survey Procedures: The General Contractor shall verify layout information shown on drawings, as required for his own Work. As Work proceeds, surveyor shall check every major element for line, level, and plumb (as applicable), and maintain an accurate Surveyor's log or Record Book of such checks available for General Contractor or Design Consultant's reference at reasonable times. Surveyor shall record deviations from required lines and levels, and advise Design Consultant or General Contractor promptly upon detection of deviations exceeding indicated or recognized tolerances. The General Contractor shall record deviations which are accepted (not corrected) on Record Drawings.

ARTICLE 36 TOBACCO PRODUCTS PROHIBITED

36.1 For areas located within Fayette County, Kentucky, the use of all tobacco products is prohibited on all property that is owned, operated, leased, occupied, or controlled by the University. "Property" for purposes of this paragraph includes buildings and structures, grounds, parking structures, enclosed bridges and walkways, sidewalks, parking lots, and vehicles, as well as personal vehicles in these areas. To view the Lexington campus boundaries: <http://www.uky.edu/TobaccoFree/files/map.pdf>.

36.2 For areas not located within Fayette County, Kentucky, smoking is prohibited in all owned, operated, leased, or controlled University buildings and structures, parking structures, enclosed bridges and walkways, and vehicles. Smoking is also prohibited outside buildings and structures within 20 feet of entrances, exits, air intakes, and windows, unless further restricted by division policy.

36.3 General Contractor employees violating this prohibition will be subject to dismissal from the Project.

36.4 For the full Administrative Regulation see University AR 6:5. <http://www.uky.edu/Regs/files/ar/ar6-5.pdf>

ARTICLE 37 ALTERNATES (NOT USED)

ARTICLE 38 FIELD CONSTRUCTED MOCKUPS (NOT USED)

ARTICLE 39 PROJECT COORDINATION VIA COMPUTER

39.1 The General Contractor and subcontractors are required to have an active email account to facilitate coordination of the project during construction and warranty.

39.2 To facilitate project construction coordination between the Consultant, the General Contractor, Subcontractors, and the University of Kentucky as the Owner, UK Capital Project Management Division (CPMD) is hosting an Internet/ Web-based Project Management System (WPMS) to help improve project communication and collaboration. The Consultant shall participate in the use of the WPMS (UK E-Communication® or other system at the Owner's discretion) providing collaboration between Owner, the Consultant and selected contractors.

39.2.1 Owner shall provide the General Contractor and subcontractors with user accounts and appropriate training for the web-based project management tool.

39.2.2 Utilization of, and training in the use of, the WPMS will be arranged for and supervised by Owner.

39.2.3 Participation of General Contractor is mandatory; others as determined by Owner. Participation of Subcontractors is not mandatory but will be offered at their discretion.

39.2.4 All participants are required to have access to the internet and the Microsoft Internet Explorer browser (version 5.0 or higher). A broadband connection to the internet (e.g. Cable modem, ISDN, DSL) is recommended, but not required.

010000S01- Special Conditions - General Contractor

39.2.5 The WPMS shall be utilized for the following functions, as a minimum: Posting Project Files, AE Amendments, Architect's Supplemental Information (ASI's), Closeouts, Consultant Invoices, Contracts, Defective Work in Place, Meeting Minutes, Payment Applications, Proposed Change Orders – Change Orders (PCO to CO's), Punch Lists, Reports (Contractor Daily Reports, Field Reports, Commissioning Reports), RFIs, SAP Equipment List, Schedules, and Submittals. The Document Library (Bid set Plans, Specifications and Addenda will be uploaded by Lynn Imaging.

39.2.6 Site camera monitors may be included at Owner's discretion.

39.2.7 Utilization of the WPMS shall be implemented by the Owner's representative.

39.2.8 Use of the system will provide consistent, real-time information for decision making. Additionally, all project data entered into the system will be archived to facilitate project record keeping. It is anticipated that proper use of the WPMS will improve efficiency of communications and reduce project related paperwork and clerical workload.

ARTICLE 40 HOT WORK PERMITS

40.1 All work involving open flames or producing heat and/or sparks in occupied buildings on the University of Kentucky campus will require the General Contractor to obtain approval to perform "Hot Work" on site. This includes, but is not limited to: Brazing, Cutting, Grinding, Soldering, Thawing Pipe, Torch Applied Roofing, and Cadwelding. A copy of the Hot Work Permit and the Hot Work Permit Procedure will be passed out at the Preconstruction Conference for the General Contractor's use.

ARTICLE 41 INSURANCE

41.1 Employers' Liability Insurance. The General Contractor shall acquire and maintain Employers' Liability insurance with at least \$500,000/\$500,000/\$500,000 limits of liability for all employees who will be working at the Project site.

41.2.1 Commercial General Liability Insurance. If the work involved requires the use of helicopters, a separate aviation liability policy with limits of liability of \$1,000,000 will be required. If cranes and rigging are involved, a separate inland marine policy with liability limits of \$100,000,000 will be required.

41.2.1.1 The limits of liability shall not be less than \$500,000 each occurrence combined single limits for bodily injury and property damage. If split limits are used, they shall not be less than \$500,000 for each person and each occurrence and \$500,000 for property damage.

41.2.2 Comprehensive Automobile Liability Insurance. Policy limits shall not be less than \$1,000,000 for combined single limits for bodily injury and property damage for each occurrence. As an alternative, split limits of not less than \$1,000,000 for bodily injury and \$500,000 for property damage for each occurrence shall be maintained.

41.2.3 Excess or Umbrella Liability Insurance. This policy shall have a minimum of \$1,000,000 combined single limits for bodily injury and property damage for each occurrence in excess of the applicable limits in the primary policies.

41.2.4 Workers' Compensation - Statutory Requirements (Kentucky)

ARTICLE 42 KEY ACCESS (NOT USED)

ARTICLE 43 CEILING CLEARANCE (NOT USED)

ARTICLE 44 METAL ANCHORS

010000S01- Special Conditions - General Contractor

44.1 All anchoring devices utilized to secure materials to the building shall be metal. Plastic or plastic expansion components shall not be used. This shall include all fasteners for mechanical/electrical hangers.

ARTICLE 45 CONTRACTOR/SUPERINTENDENT EXPERIENCE (NOT USED)

ARTICLE 46 LOADING DOCK (NOT USED)

ARTICLE 47 CONSTRUCTION PATH (NOT USED)

ARTICLE 48 HOSPITAL PROJECT PROCEDURE (NOT USED)

ARTICLE 49 WORKING HOURS/ACCESS: FOR MEDICAL CENTER/HOSPITAL (NOT USED)

ARTICLE 50 SECURITY BADGES AND MEDICAL CENTER SECURITY (NOT USED)

ARTICLE 51 HOSPITAL CONSTRUCTION CERTIFICATION (NOT USED)

ARTICLE 52 APPEARANCE (NOT USED)

ARTICLE 53 HIPAA (The Health Insurance Portability and Accountably Act) (NOT USED)




ARTICLE 54 SAFETY & FIRE PROCEDURES (NOT USED)

ARTICLE 55 INTERIM LIFE SAFETY MEASURES (ILSM) (NOT USED)



ARTICLE 56 TREE PROTECTION STANDARDS

Contractor will adhere to all provisions outlined in 010000S02 Tree Protection Standards.

REVISIONS		
NO.	DATE	DESCRIPTION

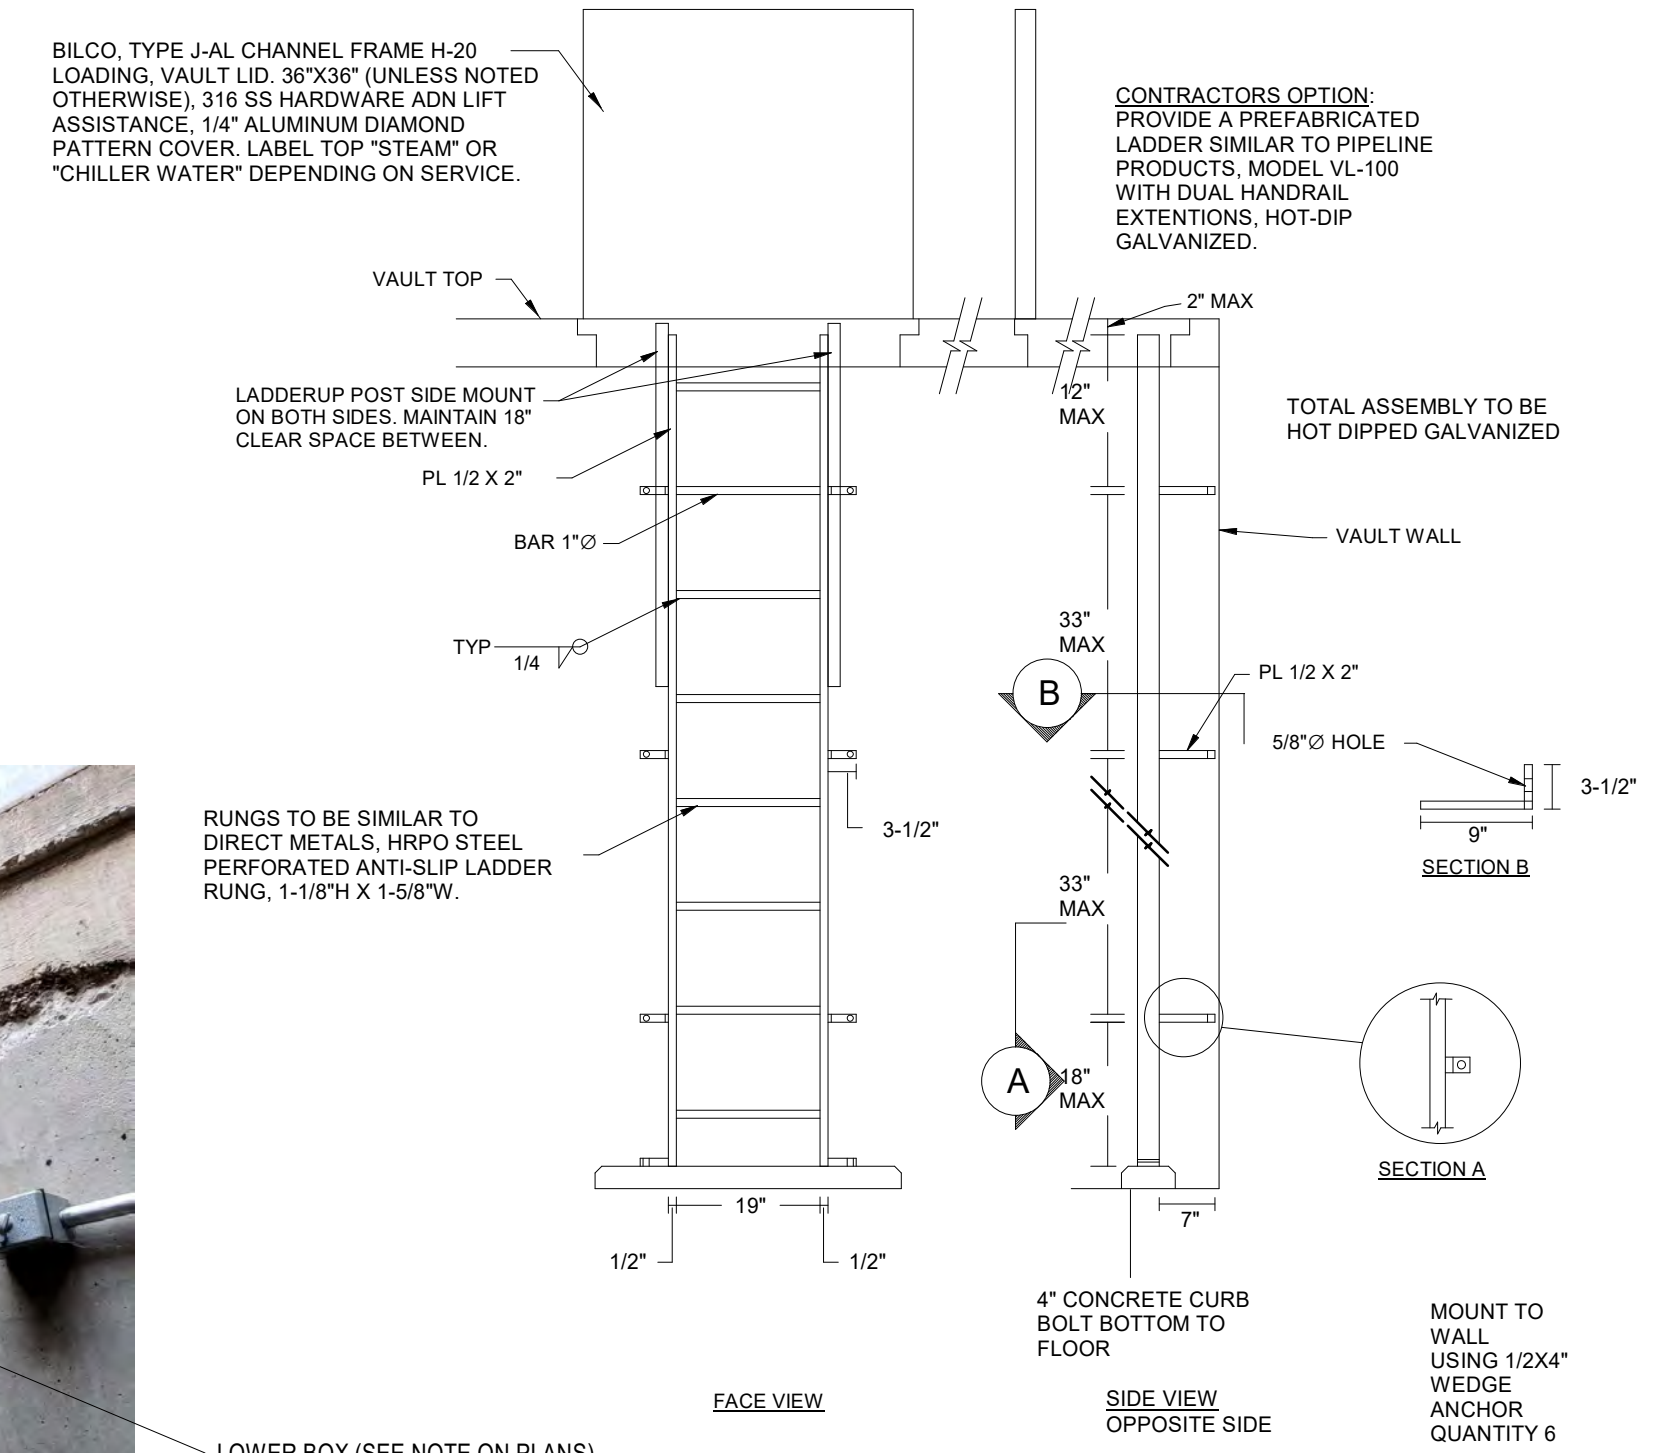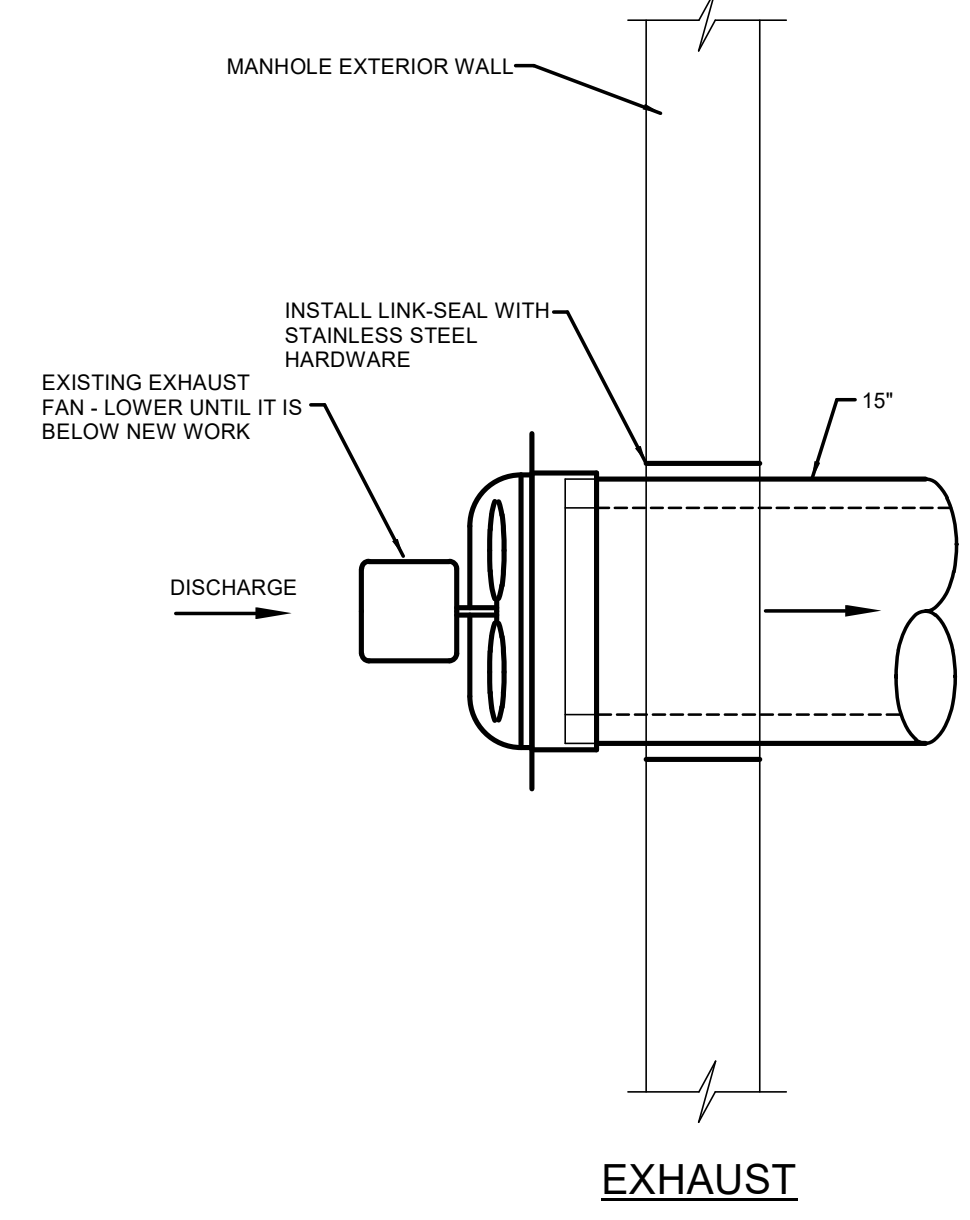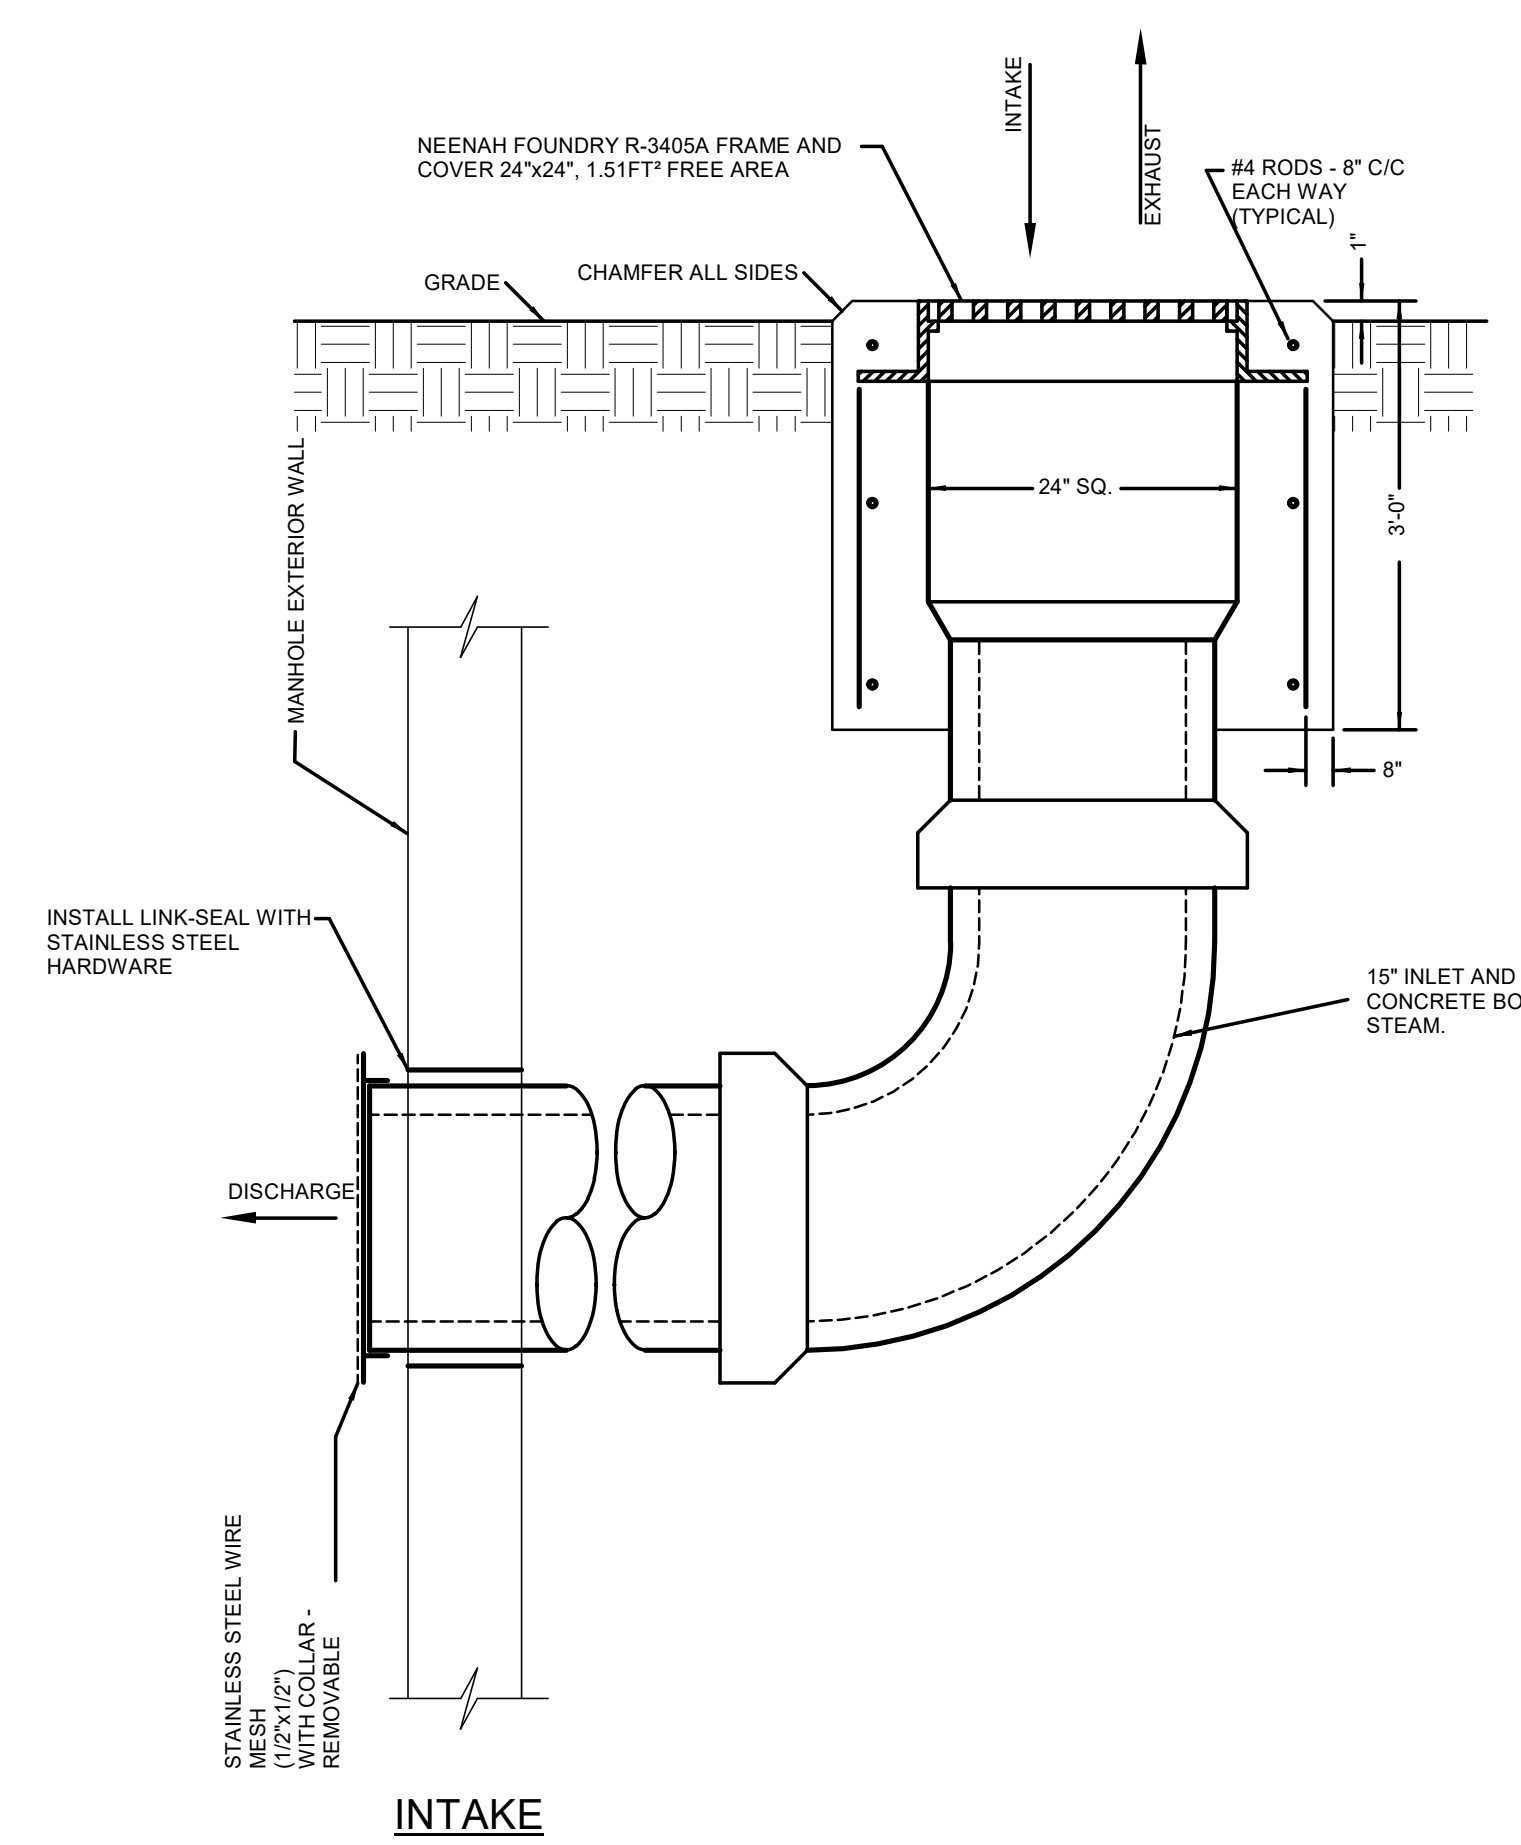

VENTILATION INLET/EXHAUST DETAIL
 SCALE: NONE

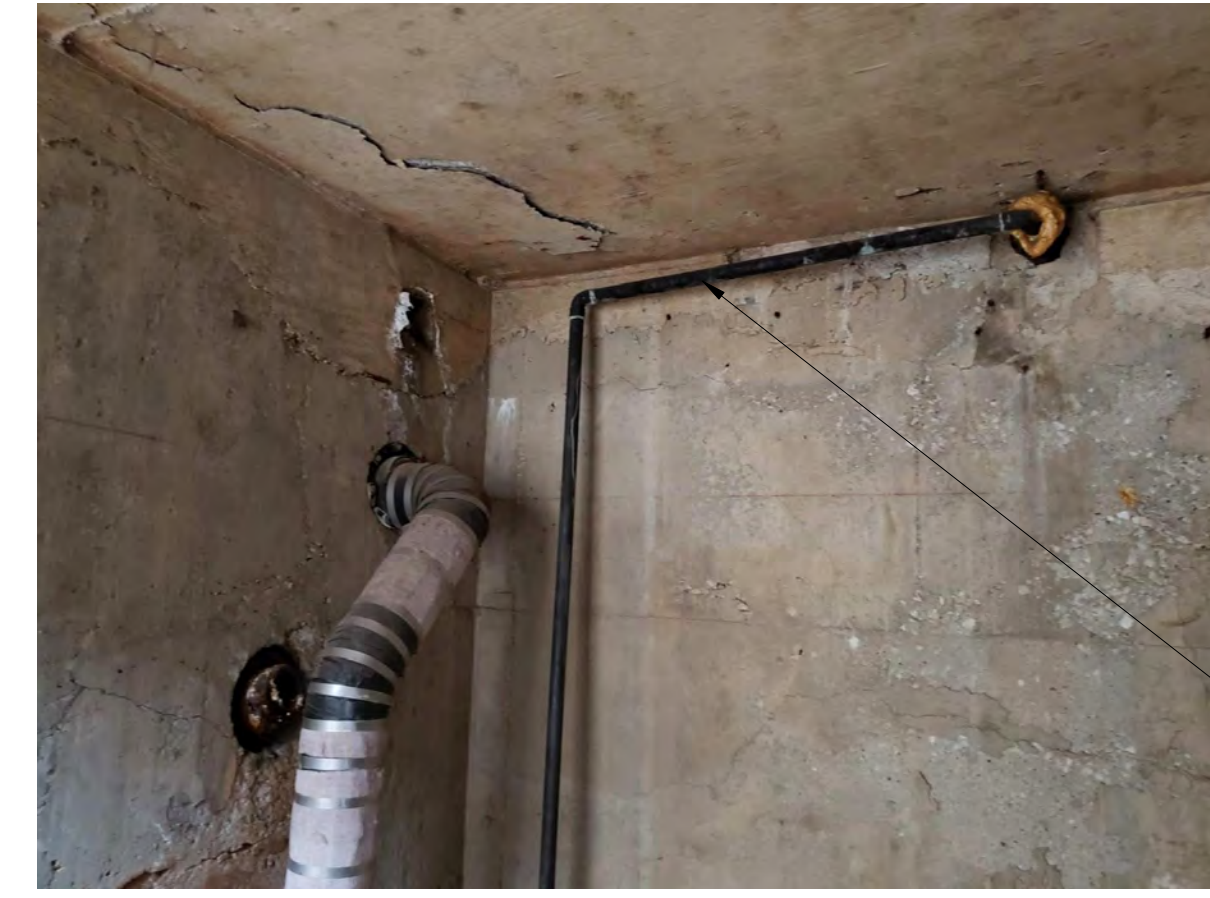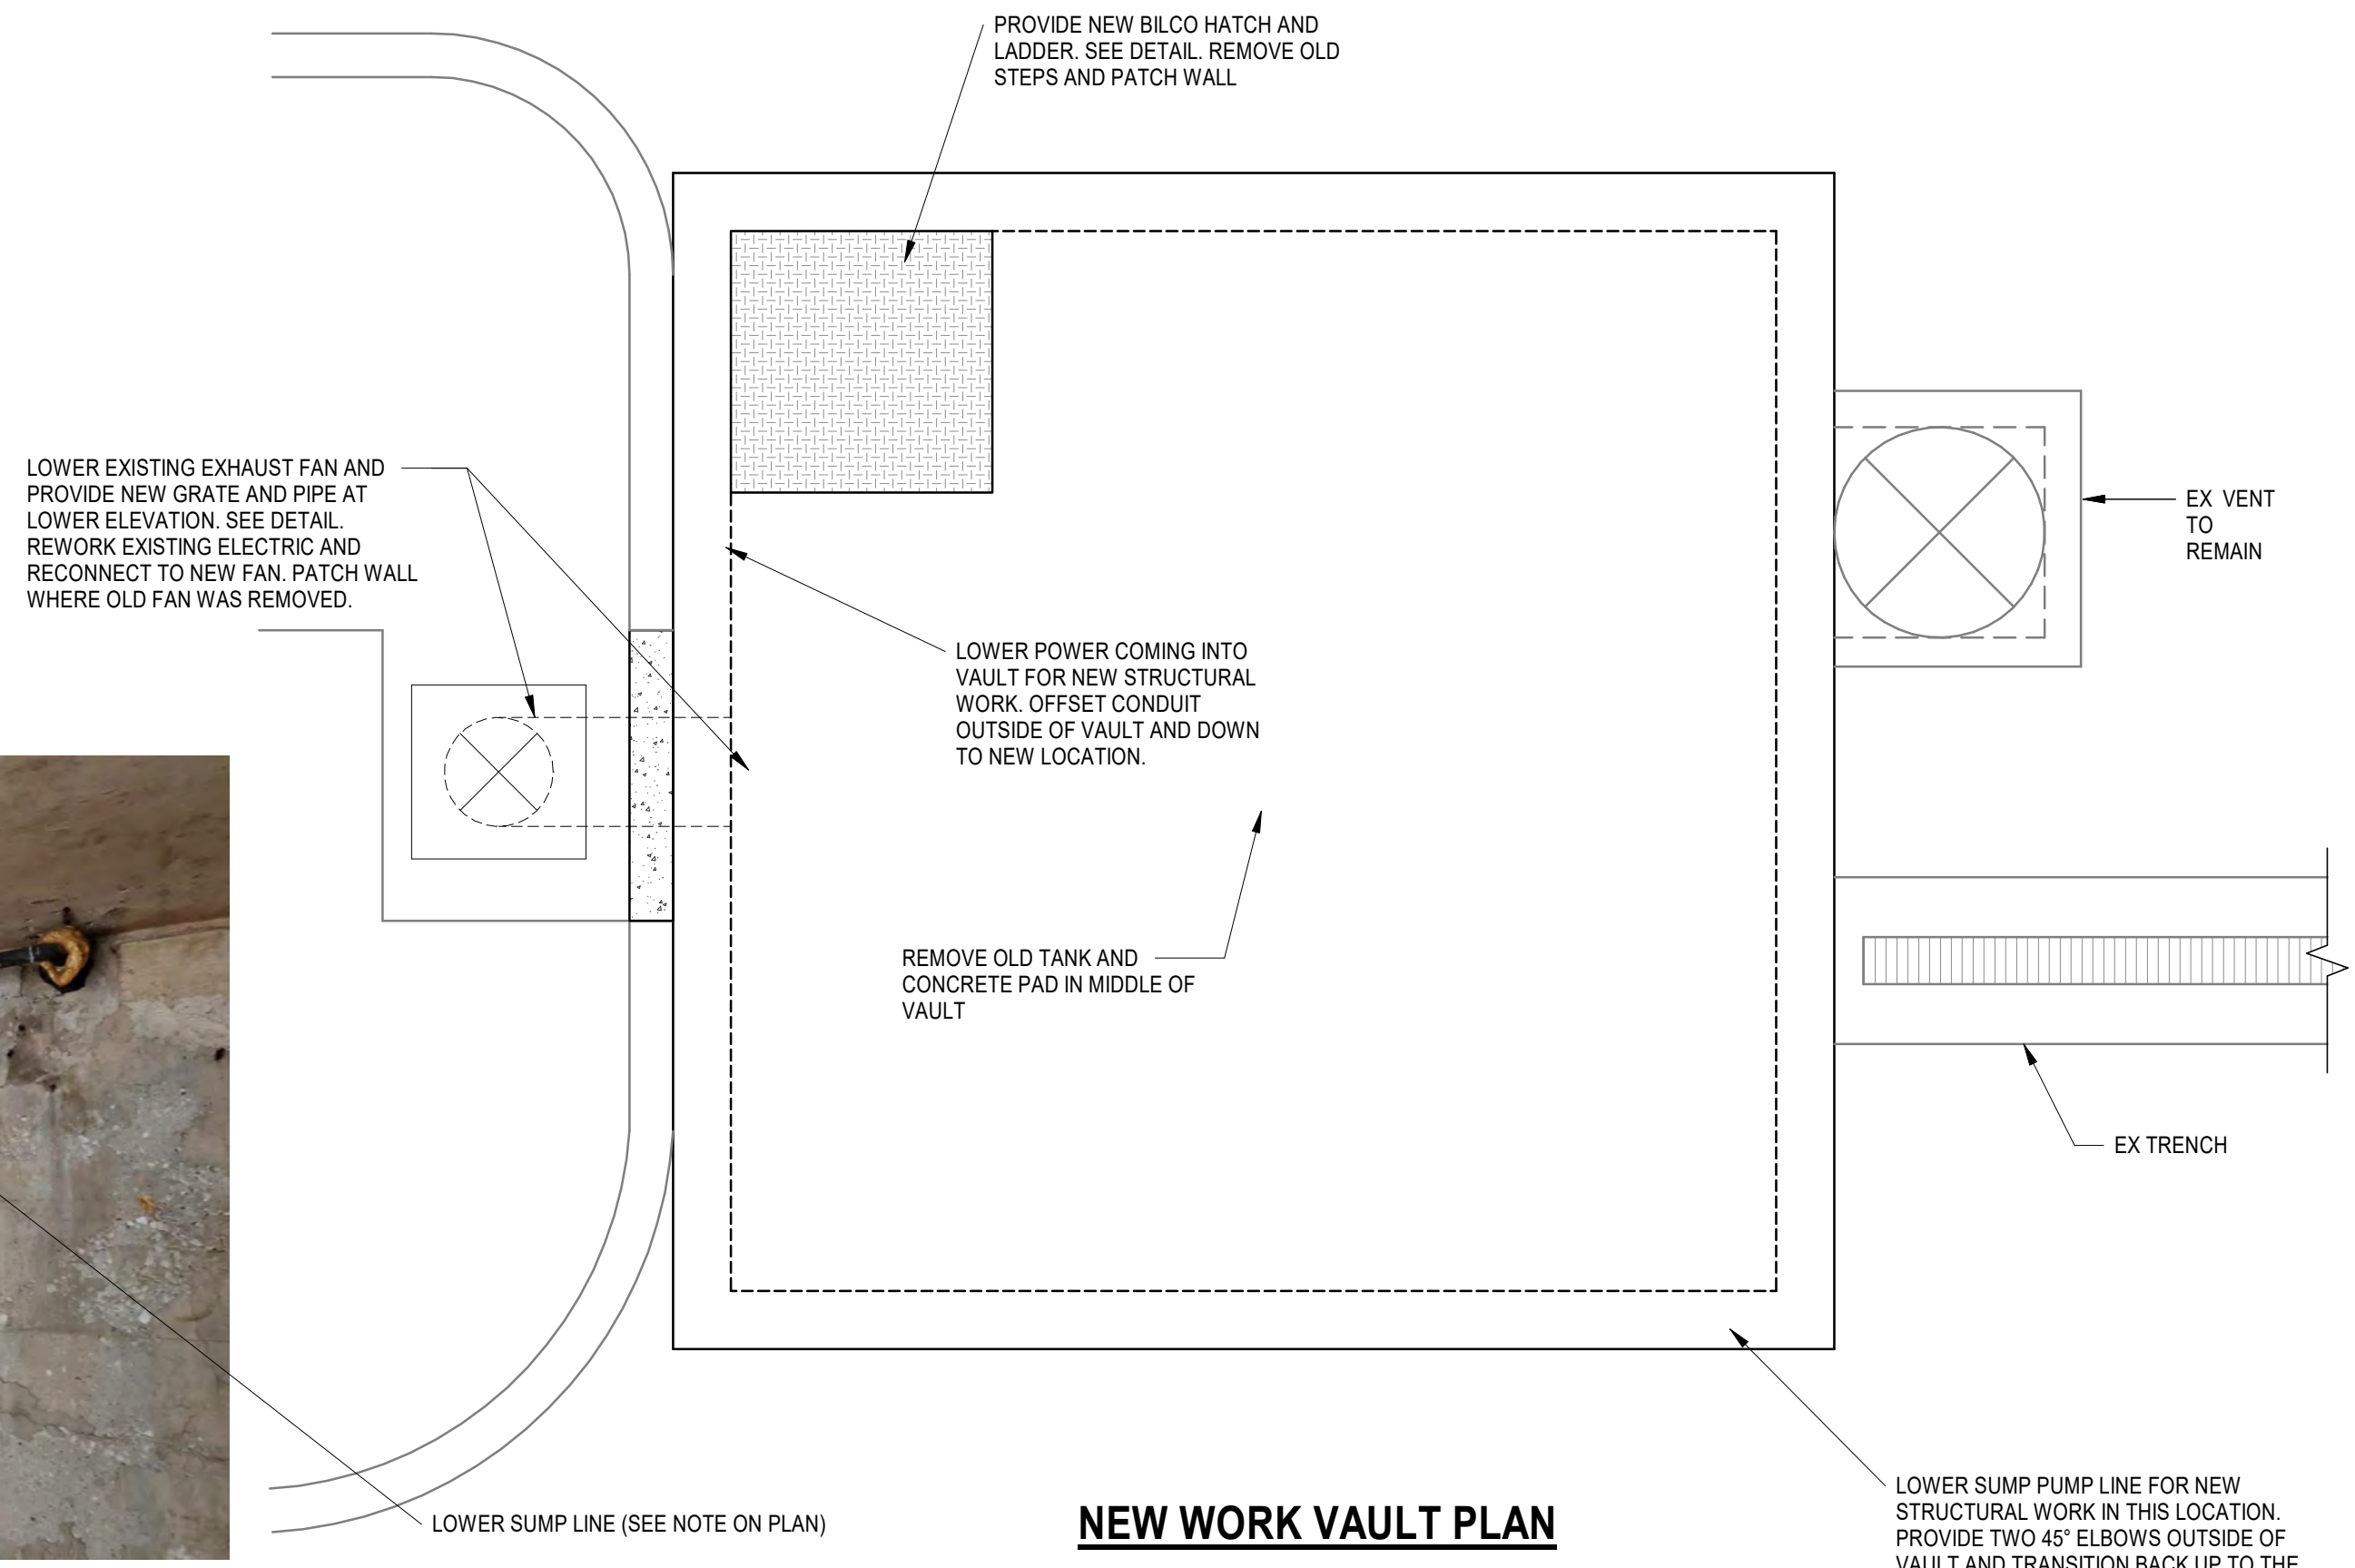

GENERAL MEP SPECIFICATIONS
 DISCONNECT, DEMOLISH, AND REMOVE ALL PIPING NOTED AND REMOVE FROM THE SITE. PATCH BACK AND INSULATION DAMAGED WITH LIKE KIND.
 ALL OTHER EXISTING WORK TO REMAIN (SUCH AS PIPING, VALVES, ETC.) SHALL BE PROTECTED FROM DAMAGE DURING DEMOLITION. CONSTRUCT PROTECTIVE BARRIERS AS NEEDED. ANY DAMAGED MATERIAL WILL BE REPLACED.
 IF PIPE, INSULATION, OR EQUIPMENT TO REMAIN IS DAMAGED IN APPEARANCE OR IS UNSERVICEABLE, REMOVE DAMAGED OR UNSERVICEABLE PORTIONS AND REPLACE WITH NEW PRODUCTS OF EQUAL CAPACITY AND QUALITY.
 COPPER PIPE FOR THE PUMP DISCHARGE SHALL BE TYPE K.
 ALL CONDUIT SHALL BE RIGID TO MATCH EXISTING.

GENERAL NOTES

DESIGN STRESS LIVE LOADS

AASHTO H20-44 DESIGN TRUCK LOAD	
ROAD SURCHARGE	120 PSF
EARTH EQUIVALENT FLUID PRESSURE (ASSUMED)	60 PCF

DESIGN STRESSES

CONCRETE (STRENGTH DESIGN) MINIMUM COMPRESSIVE STRENGTH IN 28 DAYS:	
VAULT WALL, TOP SLAB, AND CURB	$f_c = 5,000$ PSI
REINFORCING BARS (ASTM A615 GRADE 60)	$f_y = 60,000$ PSI

GENERAL

- THE REQUIREMENTS OF THESE GENERAL NOTES APPLY UNLESS OTHERWISE NOTED ON PLANS OR IN SPECIFICATIONS.
- THE CONTRACTOR SHALL VERIFY ALL DIMENSIONS IN THE FIELD PRIOR TO COMMENCING WORK. THE ENGINEER SHALL BE NOTIFIED OF ANY DISCREPANCIES THAT MAY EXIST.
- ANY DISCREPANCIES BETWEEN STRUCTURAL AND MECHANICAL DRAWINGS SHALL BE BROUGHT TO THE ATTENTION OF THE MECHANICAL AND STRUCTURAL ENGINEER.
- DO NOT SCALE DRAWINGS.
- THE CONTRACTOR SHALL FURNISH AND INSTALL ALL NECESSARY BRACING REQUIRED TO PROPERLY CONSTRUCT THE STRUCTURE UNTIL THESE ELEMENTS ARE COMPLETE AND CAPABLE OF PROVIDING THIS SUPPORT.
- THE CONTRACTOR SHALL BE SOLELY RESPONSIBLE FOR MEANS AND METHODS TO CONSTRUCT THE STRUCTURE, INCLUDING VERIFICATION OF LOAD CAPACITY OF THE STRUCTURE, NEW OR EXISTING, TO SUPPORT CONSTRUCTION ACTIVITIES, EQUIPMENT, ETC., AND FOR LIMITING THE AMOUNT OF CONSTRUCTION LOAD IMPOSED ON THE STRUCTURAL FRAMING. CONSTRUCTION LOADS SHALL NOT EXCEED THE DESIGN CAPACITY OF THE FRAMING AT THE TIME THE LOADS ARE IMPOSED. DAMAGE TO THE STRUCTURE CAUSED BY CONSTRUCTION ACTIVITIES SHALL BE CORRECTED BY THE RESPONSIBLE CONTRACTOR AT NO ADDITIONAL COST TO THE OWNER.
- SHOP DRAWINGS MUST BE CHECKED AND STAMPED BY THE CONTRACTOR PRIOR TO SUBMISSION.
- ELEVATIONS SHOWN ON STRUCTURAL DRAWINGS ARE IDEALIZED ELEVATIONS BASED ON CONCRETE THICKNESS SHOWN ON DRAWINGS AND DO NOT ACCOUNT FOR SLOPECAMBER. IT IS THE RESPONSIBILITY OF THE CONTRACTORS TO COORDINATE ANY SLOPE WITH EXISTING PAVEMENT AND TRENCH AROUND AND ADJUST ELEVATIONS AS NECESSARY TO DRAIN WATER OFF THE NEW TOP SLAB.
- WALL OPENINGS AND TERMINATIONS SHOWN ON THE STRUCTURAL DRAWINGS ARE DIAGRAMMATIC ONLY. WALL TERMINATIONS AND OPENING JAMBS, HEADS, AND SILLS SHALL BE CONSTRUCTED AS SHOWN ON THE MECHANICAL DRAWINGS. IF THE MECHANICAL DRAWINGS DO NOT INCLUDE DETAILS FOR ANY OF THESE CONDITIONS, CONSULT WITH MECHANICAL ENGINEER FOR DIRECTION.
- EXISTING CONSTRUCTION SHOWN IS BASED ON EXISTING CONSTRUCTION DOCUMENTS AND/OR GENERAL CONSTRUCTION PRACTICE AND IS NOT GUARANTEED TO BE TRUE OR EXACT. CONTRACTOR SHALL FIELD VERIFY ALL EXISTING CONDITIONS RELEVANT TO THEIR WORK PRIOR TO CONSTRUCTION.
- DETAILS NOT SPECIFICALLY INDICATED SHALL BE SIMILAR TO DETAILS SHOWN FOR SIMILAR CONDITIONS.

CONCRETE CONSTRUCTION

- ALL CONCRETE CONSTRUCTION TO BE IN ACCORDANCE WITH THE BUILDING CODE REQUIREMENTS FOR REINFORCED CONCRETE ACI 301-10, ACI 318-11 AND ACI DETAILING MANUAL, EXCEPT THAT CONSTRUCTION AND REMOVAL OF FORMS AND RESHORING SHALL BE INSPECTED BY THE CONTRACTOR'S ENGINEER.
- FURNISH BAR SUPPORTS WHERE NECESSARY DURING CONSTRUCTION.
- PROVIDE PLASTIC, PLASTIC-COATED (NOT PLASTIC-TIPPED) OR STAINLESS STEEL CHAIRS IN ALL CONCRETE EXPOSED TO VIEW IN COMPLETED STRUCTURE.
- PROVIDE PIPE SLEEVES AND INSERTS IN CONCRETE WORK WHERE REQUIRED. SEE MECHANICAL DRAWINGS.
- WELDING OF REINFORCING BARS (INCLUDING TACK WELDING) IS NOT PERMITTED.
- ALL EXPOSED CORNERS OF CONCRETE SHALL BE CHAMFERED 45 DEGREES. MINIMUM CHAMFER TO BE 1/2".
- BEND ALL HORIZONTAL WALL AND FOOTING BARS 1'-0" AROUND CORNERS OR PROVIDE CORNER BARS WITH 2'-0" LAP.
- USE AIR-ENTRAINED ADMIXTURE IN ALL CONCRETE.
- USE CORROSION-INHIBITING ADMIXTURE IN ALL CONCRETE. SEE SPECIFICATION.
- SPLICES: ALL REINFORCING SPLICES SHALL BE AS TENSION LAP, U.N.O.
 - LAP ALL COMPRESSION SPLICES 30 BAR DIAMETERS OF THE LARGER BAR.
 - LAP ALL TENSION SPLICES (ALL SPLICES EXCEPT COLUMN SPLICES, U.N.O.) IN ACCORDANCE WITH THE FOLLOWING TABLE. MODIFY LENGTHS AS NOTED:

BAR SIZE	CONCRETE COMPRESSIVE STRENGTH			1. INCREASE SPLICE LENGTH BY THE FOLLOWING 2. NOTE: INCREASED LENGTHS ARE ACCUMULATIVE
	3,000 PSI	4,000 PSI	5,000 PSI	
#3	21"	19"	17"	1. HORIZONTAL TOP BARS WITH GREATER THAN 12" OF CONCRETE BELOW +30 % 2. BAR SPACING LESS THAN 2 BAR DIAMETERS +50 %
#4	29"	25"	22"	
#5	36"	31"	28"	
#6	43"	37"	33"	
#7	62"	54"	48"	
#8	71"	62"	55"	

- CONCRETE CAST AGAINST AND PERMANENTLY EXPOSED TO EARTH 3'
- CONCRETE EXPOSED TO EARTH OR WEATHER
 - NO. 6 THROUGH NO. 18 BARS 2'
 - NO. 5 BAR, W31 OR D31 WIRE AND SMALLER 1 1/2'
- CONCRETE NOT EXPOSED TO WEATHER OR IN CONTACT WITH GROUND SLABS AND WALLS
 - NO. 11 BAR AND SMALLER 3/4'

ROOF, FLOOR, OR WALL OPENINGS

- THE CONTRACTOR SHALL VERIFY AND COORDINATE THE NUMBER, SIZE, AND LOCATION OF ALL SLEEVES AND OPENINGS REQUIRED FOR MECHANICAL OR ELECTRICAL ITEMS.
- SLEEVES AND OPENINGS SHALL BE LOCATED IN A MANNER THAT WILL MAINTAIN THE STRUCTURAL INTEGRITY OF THE ROOF, FLOOR, OR WALL SYSTEM.
- NO STRUCTURAL ELEMENTS ARE TO BE CUT UNLESS SPECIFICALLY APPROVED BY THE ENGINEER.

INSPECTION

AN APPROVED INDEPENDENT TESTING LABORATORY SHALL PROVIDE INSPECTION AND TESTING SERVICES PER ASTM E329. REPORTS OF INSPECTION AND TESTING SHALL BE SENT TO THE ARCHITECT. SUCH INSPECTION AND TESTING SHALL INCLUDE:

- CONCRETE: MIX DATA, DAILY POUR REPORTS, CYLINDER TESTS, SLUMP, ENTRAINED AIR TESTS, AND TEMPERATURE
- REINFORCEMENT: PLACEMENT, TYPE, AND SIZE.

NOTE:
THE GENERAL CONTRACTOR SHALL BE SOLELY RESPONSIBLE FOR DESIGNING, SUPPLYING, AND INSTALLING ALL TEMPORARY SHORING NECESSARY TO INSTALL NEW STRUCTURAL ELEMENTS. THE DESIGN OF THE SHORING MUST BE DONE BY A PROFESSIONAL ENGINEER LICENSED TO PRACTICE IN THE STATE OF KENTUCKY. THE CONTRACTOR SHALL SUBMIT TO THE ENGINEERS (FOR THEIR RECORDS) TEMPORARY SHORING DRAWINGS (PLANS AND ANY NECESSARY DETAILS), SEALED, SIGNED AND DATED BY THE PROFESSIONAL ENGINEER RESPONSIBLE FOR THEIR PREPARATION.

STRUCTURAL ABBREVIATIONS

ARCH	ARCHITECTURAL
BOT	BOTTOM
BTWN	BETWEEN
CLR	CLEAR
C.I.P.	CAST-IN-PLACE
C.J.P	COMPLETE JOINT PENETRATION
CONC	CONCRETE
CONT	CONTINUOUS
D	DEEP
DET	DETAIL
DWGS	DRAWINGS
EA	EACH
E.F.	EACH FACE
ELEV	ELEVATION
EMBED	MINIMUM EMBEDMENT DEPTH INTO SUBSTRATE
E.W.	EACH WAY
EXP	EXISTING
EXP	EXPANSION
F.F.E.	FINISHED FLOOR ELEVATION
F.S.	FAR SIDE
FTG	FOOTING
F.V.	FIELD VERIFY
GALV	GALVANIZED
GA	GAUGE
HORIZ	HORIZONTAL
HSS	HOLLOW STRUCTURAL SECTION
LBS	POUNDS
L.D.H.	LONG DIMENSION HORIZONTAL
L.D.V.	LONG DIMENSION VERTICAL
MANUF.	MANUFACTURER
MAX	MAXIMUM
MECH	MECHANICAL
M.E.P.	MECHANICAL/ELECTRICAL/PLUMBING
MIN	MINIMUM
N.S.	NEAR SIDE
N.T.S.	NOT TO SCALE
O.C.	ON CENTER
O.P.H.	OPPOSITE HAND
P.A.F.	POWDER ACTUATED FASTENER
P.J.P	PARTIAL JOINT PENETRATION
PL	PLATE
R	RADIUS
REINF	REINFORCEMENT
S.C.	SLIP CRITICAL
SIM	SIMILAR
S.O.G.	SLAB ON GRADE
S.S.	STAINLESS STEEL
TYP	TYPICAL
U.N.O.	UNLESS NOTED OTHERWISE
VERT	VERTICAL
W	WIDE
W.W.F.	WELDED WIRE FABRIC

MATERIAL LEGEND

	BEDROCK
	CRUSHED STONE
	NATIVE EARTH / ENGINEERED FILL
	CONCRETE
	MANHOLE HATCH



VIEW OF TOP SLAB OF EXISTING VAULT
CRACKS AND STANDING WATER WERE OBSERVED AT THE TOP OF THE EXISTING VAULT.



INTERIOR VIEW OF DELAMINATED EXISTING TOP SLAB
CRACKS, SPALLING CONCRETE, AND EXPOSED CORRODED BARS WERE OBSERVED AT THE BOTTOM SURFACE OF THE EXISTING VAULT TOP SLAB.



VIEW OF EXISTING EXHAUST FAN AND VENT
AN EXISTING EXHAUST FAN WAS OBSERVED NEXT TO THE MANHOLE OPENING OF THE EXISTING VAULT. REMOVING EXISTING TOP SLAB AND INSTALLING NEW SLAB REQUIRES MODIFICATION OF THE EXISTING OPENING AND LOWER THE EXISTING FAN (SEE MECH DWGS).



VIEW OF MANHOLE ACCESS OF EXISTING VAULT
CRACKS AND SPALLING CONCRETE WERE OBSERVED AT THE WALL SURFACE OF THE EXISTING VAULT AT MANHOLE ACCESS.



©BROWN + KUBICAN, PSC

FAILURE TO ABIDE BY DESIGN DOCUMENTS OR TO OBTAIN GUIDANCE

THE DESIGN PROFESSIONAL WAIVES ANY AND ALL RESPONSIBILITY AND LIABILITY FOR PROBLEMS WHICH ARISE FROM FAILURE TO FOLLOW THESE PLANS, SPECIFICATIONS AND THE DESIGN INTENT THEY CONVEY, OR FOR PROBLEMS WHICH ARISE FROM OTHERS FAILURE TO OBTAIN AND/OR FOLLOW THE DESIGN PROFESSIONAL'S GUIDANCE WITH RESPECT TO ANY ERRORS, OMISSIONS, INCONSISTENCIES, AMBIGUITIES OR CONFLICTS WHICH ARE ALLEGED.

GENERAL NOTES

Vault HPS 049 Top Slab Replacement
University of Kentucky
Lexington, Kentucky

DRAWN BY: ZJW
CHECKED BY: ZJW
DATE: 08/18/2022

PROJECT NUMBER
22272

REVISIONS

NO.	DATE	DESCRIPTION

SHEET

S1.1



BROWN KUBICAN
STRUCTURAL ENGINEERS
2224 Young Drive | Lexington, KY 40505
859-543-0733 | www.brownkubican.net



©BROWN + KUBICAN, PSC

FAILURE TO ABIDE BY DESIGN DOCUMENTS OR TO OBTAIN GUIDANCE

THE DESIGN PROFESSIONAL WAIVES ANY AND ALL RESPONSIBILITY AND LIABILITY FOR PROBLEMS WHICH ARISE FROM FAILURE TO FOLLOW THESE PLANS, SPECIFICATIONS AND THE DESIGN INTENT THEY CONVEY, OR FOR PROBLEMS WHICH ARISE FROM OTHERS' FAILURE TO OBTAIN AND/OR FOLLOW THE DESIGN PROFESSIONAL'S GUIDANCE WITH RESPECT TO ANY ERRORS, OMISSIONS, INCONSISTENCIES, AMBIGUITIES OR CONFLICTS WHICH ARE ALLEGED.

EXISTING, DEMOLISH PLANS AND DETAILS
Vault HPS 049 Top Slab Replacement
University of Kentucky
Lexington, Kentucky

DRAWN BY: ZJW
CHECKED BY: ZJW
DATE: 08/18/2022


PROJECT NUMBER
22272

REVISIONS


NO.	DATE	DESCRIPTION

SHEET


S2.1

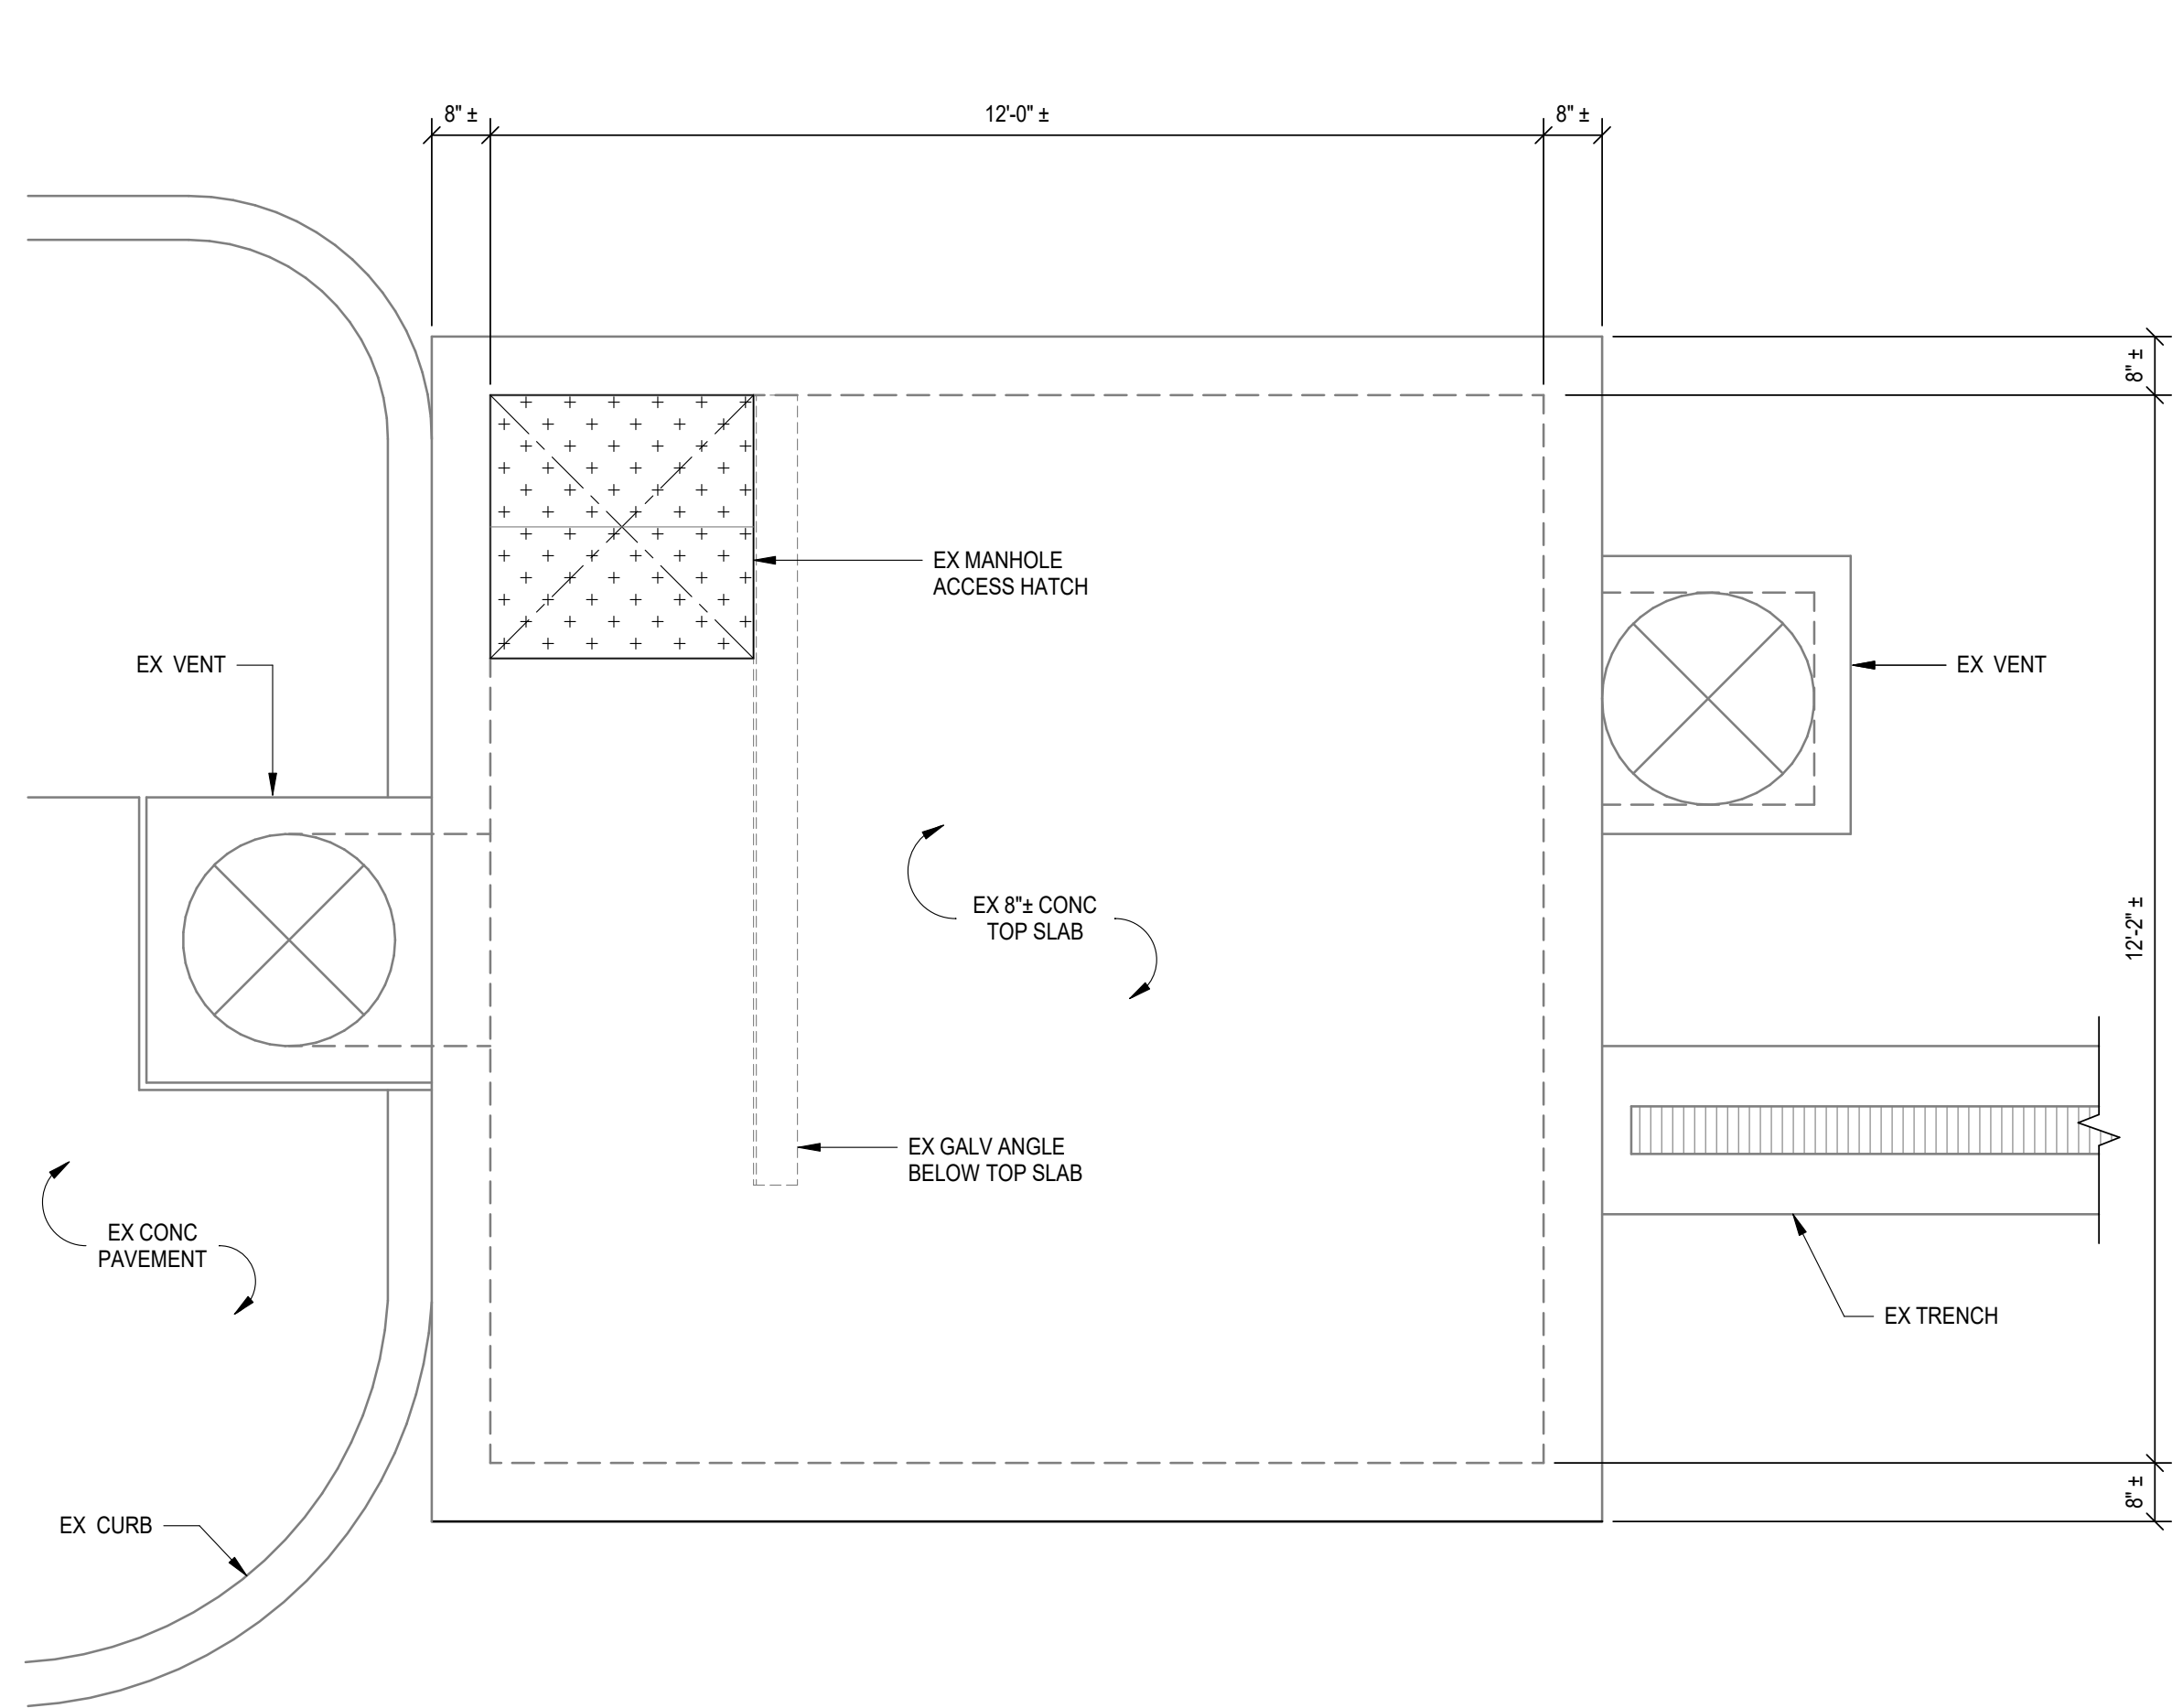

A
S2.1
EXISTING CONCRETE VAULT PLAN
1/2" = 1'-0"

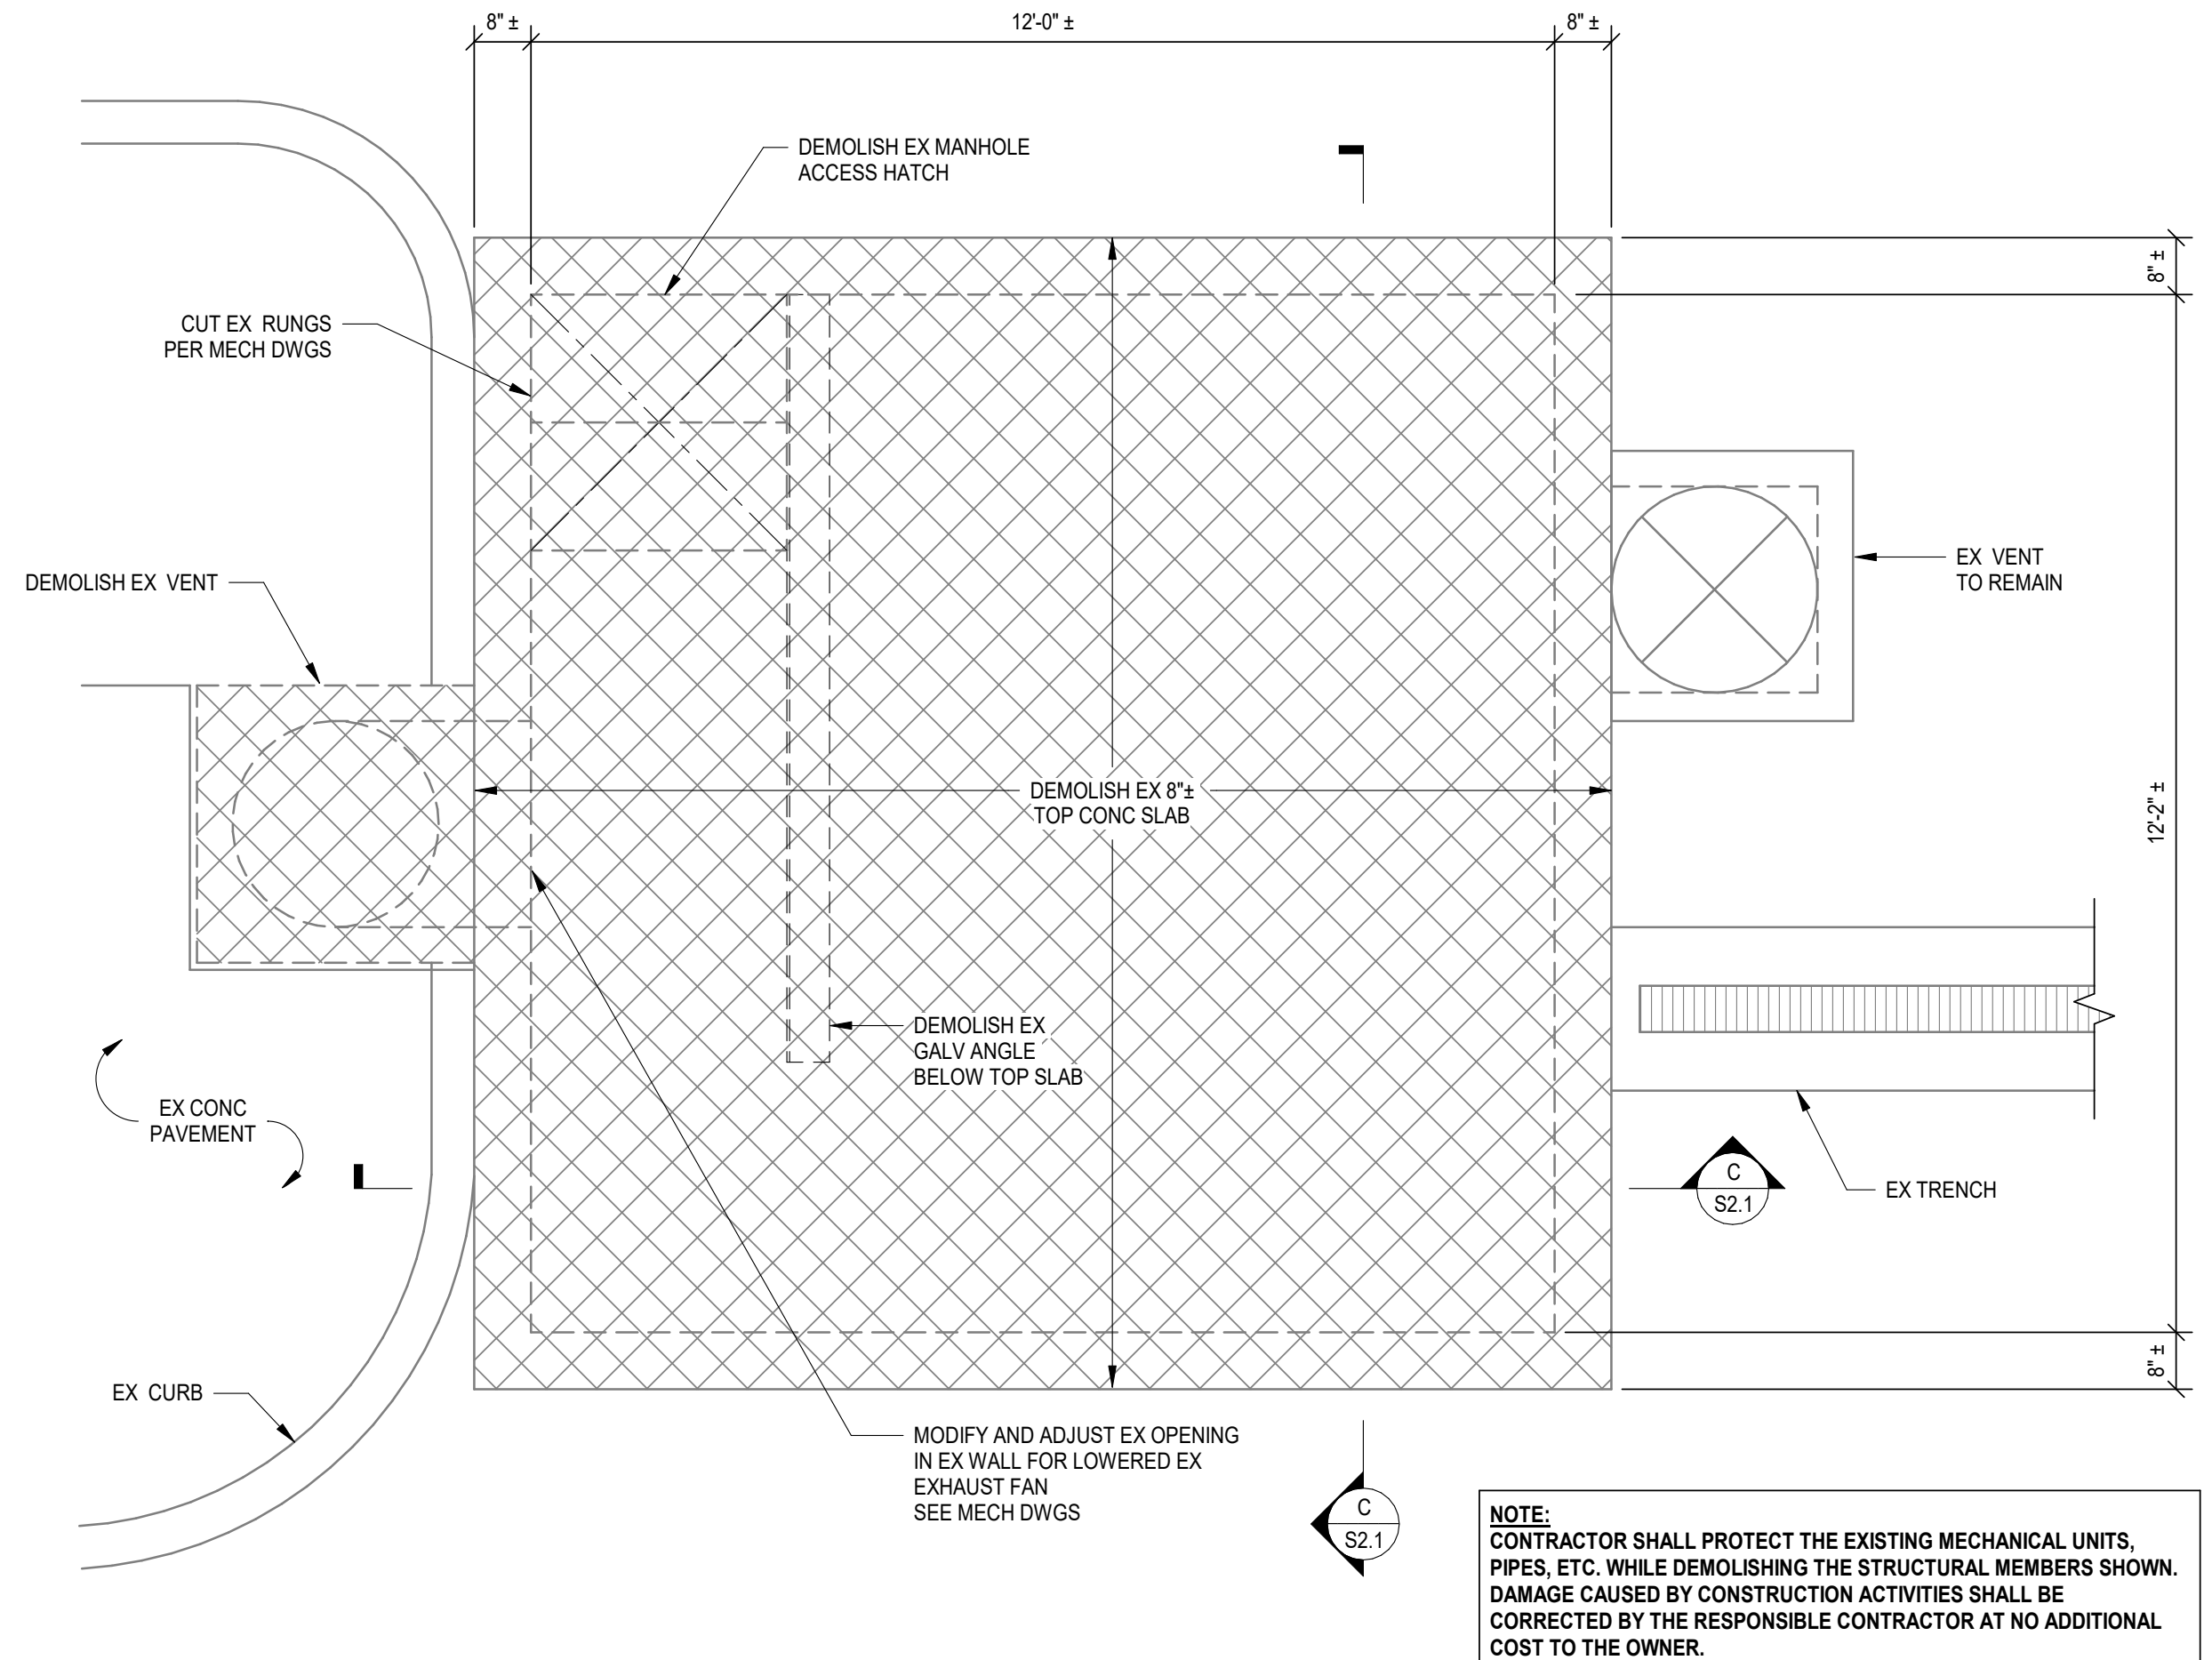

B
S2.1
DEMOLISH PLAN
1/2" = 1'-0"

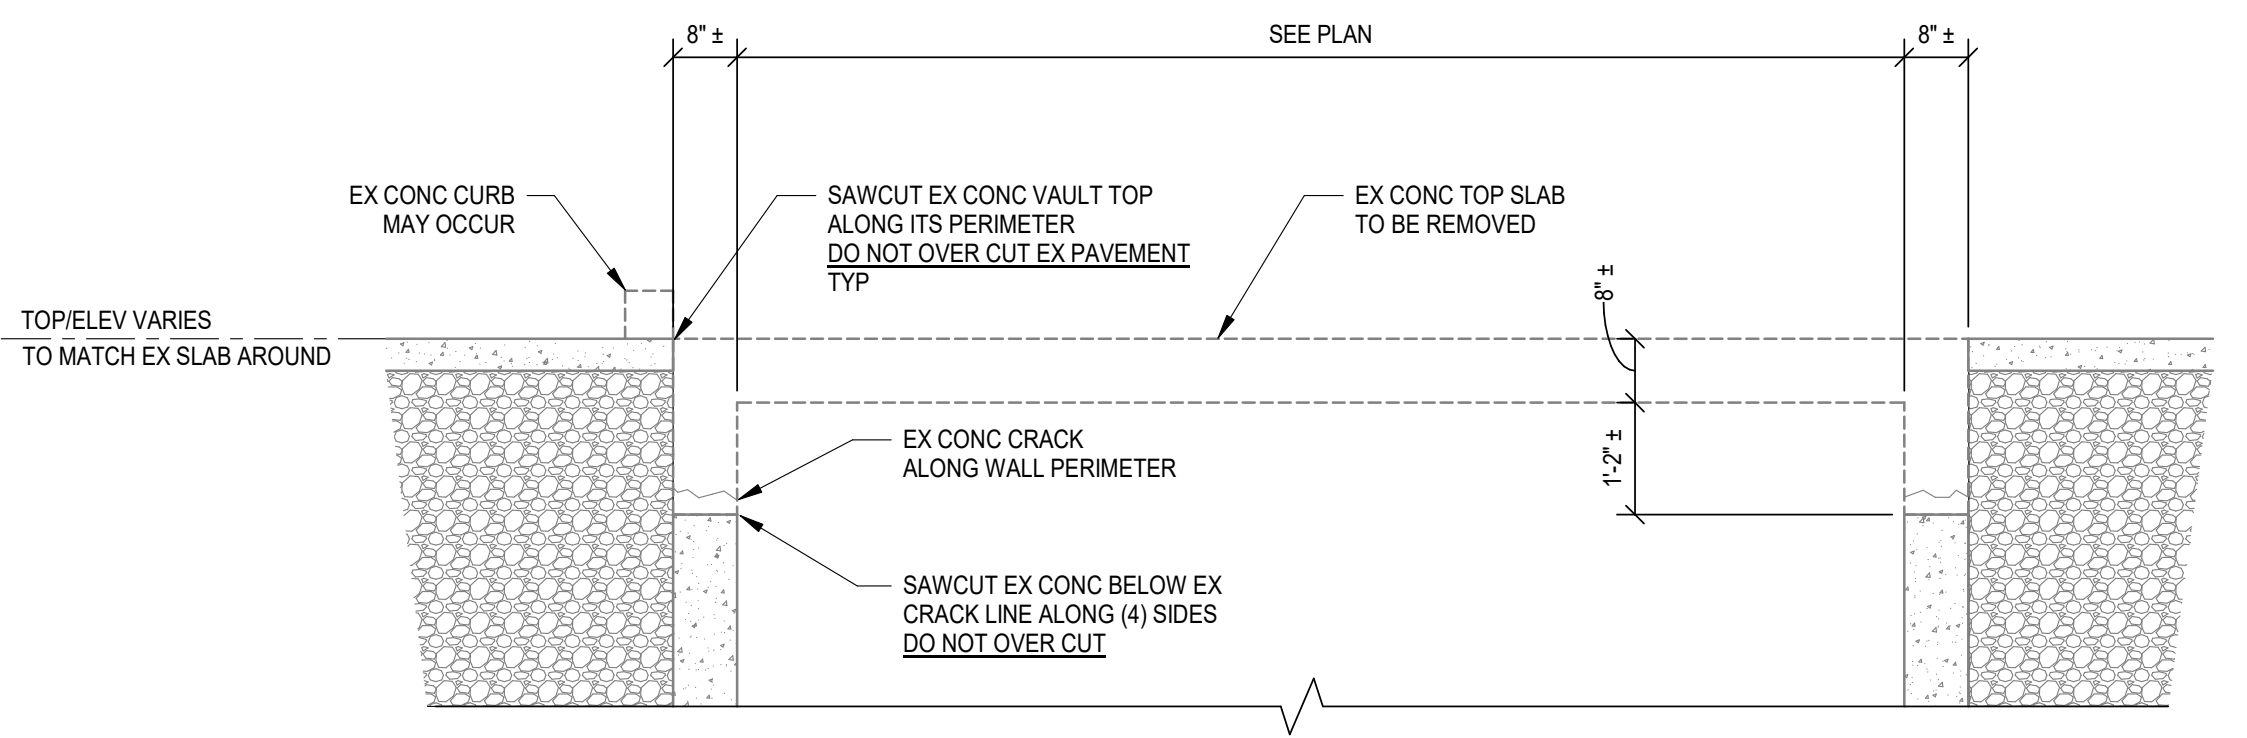

C
S2.1
DEMOLISH DETAILS
1/2" = 1'-0"



BROWN + KUBICAN
STRUCTURAL ENGINEERS

2224 Young Drive | Lexington, KY 40505
859-543-0733 | www.brownskuban.com



©BROWN + KUBICAN, PSC

FAILURE TO ABIDE BY DESIGN DOCUMENTS OR TO OBTAIN GUIDANCE

THE DESIGN PROFESSIONAL WAIVES ANY AND ALL RESPONSIBILITY AND LIABILITY FOR PROBLEMS WHICH ARISE FROM FAILURE TO FOLLOW THESE PLANS. SPECIFICATIONS OR OTHER FAILURE TO OBTAIN OR FOLLOW THE DESIGN PROFESSIONAL'S GUIDANCE WITH REFERENCE TO ANY ERRORS, OMISSIONS, INCONSISTENCIES, AMBIGUITIES OR CONFLICTS WHICH ARE ALLEGED.

SPECIFICATIONS
Vault HPS 049 Top Slab Replacement
University of Kentucky
Lexington, Kentucky

DRAWN BY: ZJW
CHECKED BY: ZJW
DATE: 08/18/2022

PROJECT NUMBER
22272

REVISIONS		
NO.	DATE	DESCRIPTION

SHEET

S3.2

SPECIFICATIONS

- C. Related Unformed Surfaces: At tops of walls, horizontal offsets, and similar unformed surfaces adjacent to formed surfaces, strike-off smooth and finish with a texture matching adjacent formed surfaces. Continue final surface treatment of formed surfaces uniformly across adjacent unformed surfaces unless otherwise indicated.
- 3.12 FINISHING FLOORS AND SLABS
 - A. General: Comply with ACI 302.1R recommendations for screeding, restriaitening, and finishing operations for concrete surfaces. Do not wet concrete surfaces.
 - B. Float Finish: Apply float finish to monolithic slab surfaces to receive trowel finish and other finishes as specified; slab surfaces to be covered with fluid-applied or sheet waterproofing, built-up or membrane roofing, or sand-bed terrazzo; and where indicated.
 - 1. After screeding, consolidating, and leveling concrete slabs, do not work surface until ready for floating. Begin floating, using float blades or float shoes only, when surface water has disappeared, or when concrete has stiffened sufficiently to permit operation of power-driven floats, or both. Consolidate surface with power-driven floats or by hand-floating if area is small or inaccessible to power units. Cut down high spots and fill low spots. Uniformly slope surfaces to drains. Immediately after leveling, refloat surface to a uniform, smooth, granular texture.
 - C. Trowel Finish: Apply a trowel finish to monolithic slab surfaces exposed to view and slab surfaces to be covered with resilient flooring, carpet, ceramic or quarry tile, paint, or another thin film-finish coating system.
 - 1. After screeding, consolidating, and leveling concrete slabs, do not work surface until ready for floating. Begin floating, using float blades or float shoes only, when surface water has disappeared, or when concrete has stiffened sufficiently to permit operation of power-driven floats, or both. Consolidate surface with power-driven floats or by hand-floating if area is small or inaccessible to power units.
 - 2. Allow moisture film or sheen to disappear from the floated surface and allow the concrete to harden enough to prevent fine material and water from being worked into the concrete surface. Then begin first trowel-finish operation using a power-driven trowel. Begin final troweling when surface produces a ringing sound as trowel is moved over surface. Consolidate concrete surface by final hand-troweling operation, free of trowel marks and uniform in texture and appearance.
 - D. Nonslip Broom Finish: Apply a nonslip broom finish to exterior concrete platforms, steps, ramps, and elsewhere as indicated.
 - 1. Immediately after float finishing, slightly roughen concrete surface by brooming with fiber-bristle broom perpendicular to main traffic route. Coordinate required final finish with Engineer before application.
 - E. Surface Cleaning: Where concrete surface is to be left exposed or sealed with thin film of penetrating coating, burnish or burn to remove all protruding synthetic fiber reinforcing.
 - F. Exposed Concrete Slabs: Slabs exposed to view in the public spaces shall be free of trowel marks and uniform in texture and appearance. Sharply defined low and high spots are prohibited and cause for rejection by Engineer. Grinding and patching to correct discrepancies will be prohibited unless acceptable to Engineer. Use new concrete blankets and other protections that will not discolor or dull the finish.
- 3.13 CONCRETE PROTECTING AND CURING
 - A. General: Protect freshly placed concrete from premature drying and excessive cold or hot temperatures.
 - B. Cleanliness for Architecturally Exposed Concrete Slabs: Slabs to be left exposed in public places and to be sealed with densifier/sealers, hardeners, or similar shall remain clean from dirt and other agents which might discolor the finish. Install new, clean polyethylene film over slabs and below curing blankets and other protection which might discolor or stain the raw concrete.
 - C. For cold-weather protection during curing, comply with ACI 306.1 and the following:
 - 1. All freshly placed concrete shall be kept from freezing for the following periods:
 - a. 3 days for all concrete with an air entraining admixture.
 - b. 4 days for all concrete without an air entraining admixture.
 - 2. A cumulative curing time of seven days at a minimum surface temperature of 50 degrees F (10 degrees C) shall be provided or until concrete has attained 75% of design strength. This shall be followed by cooling of concrete in a gradual transition to surrounding conditions. The temperature drop during this period shall not be at a rate exceeding 2 degrees F per hour until the outside or surrounding temperature is reached.
 - 3. When concrete is placed under conditions of cold weather concreting (defined as a period when the mean daily temperature drops below 40 degrees F for more than three successive days), take additional precautions as specified in "Cold Weather Concreting" by the American Concrete Institute (ACI Report 306) when placing, curing, monitoring and protecting the fresh concrete.
 - D. For hot-weather protection during curing, comply with ACI 301 and the following:
 - 1. When concrete is placed under conditions of hot weather concreting, provide extra protection of the concrete against excessive placement temperatures and excessive drying throughout the placing and curing operations. Hot weather is defined as air temperature which exceeds 80 degrees F or any combination of high temperature, low humidity and/or high wind velocity that causes a rate of evaporation in excess of 0.2 pounds per square foot per hour as determined by Figure 2.1.5 of ACI Report 305. Hot weather curing is required if these conditions occur within a 24-hour period after completion of concrete placement.
 - 2. Forms, reinforcing and the air shall be cooled by water fog spraying immediately before placing concrete.
 - 3. Immediately following screeding, protect concrete by applying the specified evaporation retarder in accordance with the recommendations of the manufacturer.
 - E. Formed Surfaces: Cure formed concrete surfaces, including walls, columns, sides and underside of beams, supported slabs, and other similar surfaces, by moisture curing with forms in place for 7 days or until forms are removed. If forms are removed within the first 7 days, continue moisture curing without forms for the balance of the 7-day curing period.
 - 1. For vertical surfaces, after the concrete has hardened and while the forms are still in place, the form ties shall be loosened and water shall be applied to run down the inside of the form to keep the concrete wet.
 - 2. After formwork has been removed from vertical surfaces, keep surface continuously wet by water spray or water-saturated absorbent cover.
 - F. Unformed Surfaces: Begin curing immediately after finishing concrete. Cure unformed surfaces, including floors and slabs, concrete floor toppings, and other surfaces.
 - 1. Cure exterior slab surfaces exposed to delicting salts and slabs is not compatible with curing compounds by Moisture Curing.
 - G. Cure concrete according to ACI 308.1 by one or a combination of the following methods:
 - 1. Moisture Curing: Keep surfaces continuously moist for not less than seven days with the following materials:
 - a. Water.
 - b. Continuous water-fog spray.
 - c. Absorbent cover, water saturated, and kept continuously wet. Cover concrete surfaces and edges with 12-inch lap over adjacent absorbent covers.
 - 2. Moisture-Retaining-Cover Curing: Cover concrete surfaces with moisture-retaining cover for curing concrete, placed in widest practicable width, with sides and ends lapped at least 12 inches, and sealed by waterproof tape or adhesive. Cure for not less than seven days. Immediately repair any holes or tears during curing period, using cover material and waterproof tape.
 - a. Moisture cure or use moisture-retaining covers to cure concrete surfaces to receive penetrating liquid floor treatments.
- 3.14 LIQUID FLOOR TREATMENT APPLICATION
 - A. General: Prepare, apply, and finish penetrating liquid floor treatment according to manufacturer's written instructions.
 - 1. Remove curing compounds, sealers, oil, dirt, balance, and other contaminants and complete surface repairs.

SPECIFICATIONS

- 2. Do not apply to concrete that is less than seven days old.
- 3. Apply liquid until surface is saturated, scrubbing into surface until a gel forms; rewet; and repeat brooming or scrubbing. Rinse with water; remove excess material until surface is dry. Apply a second coat in a similar manner if surface is rough or porous.
- B. Penetrating Concrete Sealer
 - 1. Apply penetrating concrete sealer to all concrete floor surfaces exposed to view in the finished structure.
- 2. Coverage rate shall be 300 square feet (maximum) per gallon.
- 3.15 CONCRETE SURFACE REPAIRS
 - A. Defective Concrete: Repair and patch defective areas when approved by Engineer. Remove and replace concrete that cannot be repaired and patched to Engineer's approval.
 - B. Patching Mortar: Mix dry-pack patching mortar, consisting of 1-part portland cement to 2-1/2 parts fine aggregate passing a No. 16 sieve, and a 50:50 mixture of acrylic or styrene butadiene-based bonding admixture and water. Use only enough liquid as required for handling and placing.
 - C. Repairing Formed Surfaces: Surface defects include color and texture irregularities, cracks, spalls, air bubbles, honeycombs, rock pockets, fins and other projections on the surface, and stains and other discolorations that cannot be removed by cleaning.
 - 1. Immediately after form removal, cut out honeycombs, rock pockets, and voids more than 1/2 inch in any dimension to solid concrete. Limit cut depth to 3/4 inch. Make edges of cuts perpendicular to concrete surface. Clean, dampen with water, and brush-coat holes and voids with bonding agent. Fill and compact with patching mortar before bonding agent has dried.
 - 2. Repair defects on surfaces exposed to view by blending white portland cement and standard portland cement so that, when dry, patching mortar matches surrounding color. Patch a test area at conspicuous locations to verify mixture and color match before proceeding with patching. Compact mortar in place and strike off slightly higher than surrounding surface.
 - D. Repairing Unformed Surfaces: Test unformed surfaces, such as floors and slabs, for finish and verify surface tolerances specified for each surface. Correct low and high areas. Test surfaces sloped to drain for trueness of slope and smoothness; use a sloped template.
 - 1. Repeat finished surfaces contains defects include spalls, popouts, honeycombs, rock pockets, crazing and cracks in excess of 0.01 inch wide or that penetrate to reinforcement or other objectionable conditions.
 - 2. Correct localized low areas during or immediately after completing surface finishing operations by cutting out low areas and replacing with patching mortar. Finish repaired areas to blend into adjacent concrete.
 - 3. Repair random cracks in exposed concrete slab on grade by fully removing and replacing slab between existing control or construction joints. Drill and install dowel bars between new and existing slab as directed by Engineer.
 - 4. Repair random cracks in exposed suspended concrete slab by fully removing and replacing slab as directed by Engineer. Slab replacement shall extend to third point of framing infill bay and girder support at composite beam systems.
 - E. Perform structural repairs of concrete, subject to Engineer's approval, using epoxy adhesive and patching mortar.
 - F. Repair methods not specified above may be used, subject to acceptance of Engineer.
- 3.16 QUALITY CONTROL
 - A. General: Contractor shall employ an independent testing and inspection agency that meets the requirements of ASTM E329 to perform inspections and tests and to prepare test reports. The agency will monitor concrete quality by means of field and laboratory tests. They will be authorized to reject plastic concrete not conforming to specifications. Failure to detect any defective materials shall not prevent later rejection when such defect is discovered, or obligate the Engineer or Owner for final acceptance.
 - 1. See Section 014120 - Structural Special Inspections and Contract Drawings for testing and inspection to be performed.
 - 2. Test results will be reported in writing to the Engineer, ready-mix producer and General Contractor within 24 hours after tests.
 - 3. Additional Tests: The testing agency will make additional tests of in-place concrete when test results indicate specified concrete strengths and other characteristics have not been attained in the structure, as directed by Engineer.
- 3.17 PROTECTION
 - A. The General Contractor shall provide for protection of exposed slab surfaces both before and after treatment by liquid floor treatments or polishing. General Contractor shall coordinate all other construction activities to ensure slab surfaces are not damaged or stained.
 - B. Use protective methods and materials, including temporary covering, recommended in writing by installer's manufacturer.
 - C. Do not allow contaminants including acids, oils, resins, etc. to contact surface. Provide continuous scuff-preventing pads covered in lapped and sealed water and oil resistant film.
 - D. Do not place any material onto surface that may cause etching, scuffing, chips, or scratches. Provide protection boards below scaffolding legs. Do not allow tracked vehicles on surface.

END OF SECTION 033000

SECTION 075700 - TRAFFIC COATINGS

PART 1 - GENERAL

- 1.2 SUBMITTALS
 - A. Manufacturer's Data: Submit specifications, installation instructions and general recommendations by the manufacturer of fluid applied waterproofing materials. Include manufacturer's certified test data showing compliance with the requirements. Provide copy of license agreement between manufacturer and installer indicating division of warranty responsibility.
 - B. Manufacturer's standard color samples for color selection by Owner.
 - C. Warranty, per requirements herein.

1.3 QUALITY ASSURANCE

- A. Codes and Standards: Comply with provisions of the following codes, specifications, and standards, except where more stringent requirements are shown or specified. See Section 033000 for ACI Documents that apply to this Section.
 - 1. AMERICAN SOCIETY FOR TESTING AND MATERIAL (ASTM)
 - 1. ASTM C882 - Standard Test Method for Bond Strength of Epoxy-Resin Systems Used With Concrete By Slant Shear
 - 2. ASTM C884 - Standard Test Method for Thermal Compatibility Between Concrete and an Epoxy-Resin Overlay
 - 3. ASTM D575 - Standard Test Method for Water Absorption of Plastics
 - 4. ASTM D638 - Standard Test Method for Tensile Properties of Plastics
 - 5. ASTM D695 - Test Method for Compressive Properties of Rigid Plastics
 - 6. ASTM D4060 - Test Method for Abrasion Resistance of Organic Coatings
 - 2. AMERICAN ASSOCIATION OF STATE HIGHWAY AND TRANSPORTATION OFFICIALS (AASHTO)
 - 4. AASHTO T277 - Standard Method of Test for Electrical Indication of Concrete's Ability to Resist Chloride Ion Penetration
- B. The contractor shall be experienced in traffic coatings. This shall be demonstrated by providing five successful project references.
- C. The manufacturer shall be experienced in concrete repair and protection. This shall be demonstrated by providing proof of producing concrete repair and protection products for a minimum of ten years. Manufacturers to be ISO 9000/9001 certified.
- D. The installer shall demonstrate qualifications to perform the work of this Section by submitting following documentation:
 - 1. Licensing or Certification by the waterproofing manufacturer as an applicator of the product to be used.

- 2. List of at least five projects (with reference names and phone numbers) satisfactorily completed under the current company name, of similar scope and complexity of this project.
- E. Deliver products in original, unopened containers with the manufacturer's name, labels, product identification, and batch numbers. Store and condition the product in full compliance with the manufacturer's recommendations.
- F. The contractor shall supply a complete warranty for workmanship for one year commencing with the date of acceptance of work. The manufacturer shall supply a complete warranty for materials for one year commencing with the date of acceptance of work.
- G. Qualifications of Workers: Use adequate numbers of skilled workers who are thoroughly trained and experienced in the necessary crafts and who are completely familiar with the specified requirements and the methods needed for proper execution of the work required by this Division.
- H. Manufacturing Qualifications: The manufacturer of the specified product shall be ISO 9001 certified and have in existence a recognized ongoing quality assurance program independently audited on a regular basis.
- I. Delivery and Storage:
 - 1. Deliver materials to project site in sealed, original packages or containers bearing name and brand of manufacturer. Each container shall have manufacturer's printed label.
 - 2. Upon delivery, notify the Engineer. Only materials brought to area and approved may be used.
 - 3. Store materials in single place and manner designated by General and Special Conditions.
 - 4. Empty containers used on project shall have labels canceled and shall be marked as reuse.
- 1.5 JOB CONDITIONS
 - A. A specified coating shall not be applied if weather is outside limitations stated by manufacturer's recommendations and requirements. Protection required for proper installation and curing shall be the responsibility of the Contractor and shall be reflected in his pricing in the Bid.
 - B. Protect adjacent surfaces and materials located below area of Work) with covering, duct tape and/or drop cloths as required to keep free of coating. Upon completion, remove protection and clean as necessary. When painted or materials damaged by special coating shall be cleaned or replaced at no extra cost to Owner.
 - C. Proceed with the installation of waterproofing only after the substrate has been prepared in accordance with manufacturer's requirements and after penetrating components have been installed, so that membrane will not be penetrated or damaged by subsequent work.
 - D. When payment for elastomeric deck coating is based on area of application, the areas used in calculations shall be horizontal surfaces only. Examine the substrate and the conditions under which the elastomeric waterproofing work is to be applied. Do not proceed with the work until satisfactory conditions have been corrected and approved by the manufacturer's representative. Installation of products constitutes Contractor's and Manufacturer's acceptance of conditions.
- 1.6 WARRANTY
 - A. Manufacturer and Contractor shall be jointly and severally responsible and shall submit an affidavit signed by both parties warranting the installed system for a minimum period of five (5) years from date of final completion. The installer shall repair or replace membrane which leaks water, deteriorates excessively, wears prematurely or otherwise fails to perform as required within the guarantee period, due to failure of materials or workmanship. The guarantee shall include an agreement to remove and replace other work which has been superimposed on elastomeric waterproofing system as required to repair or replace the waterproofing system.
 - B. Warranty information shall be submitted with Bid documentation, and shall separately list conditions or exclusions by the Owner during the Warranty period which may wholly or partially invalidate the Warranty.

PART 2 - PRODUCTS

- 2.1 TRAFFIC COATINGS: Elastomeric polyurethane waterproofing traffic-bearing membrane system
 - A. Available Products: Subject to compliance with requirements, products that may be incorporated in the Work include, but are not limited to, the following:
 - 1. Neogard Auto-Gard Vehicular Traffic Coatings

The system consists of an epoxy primer applied to the cleaned concrete surface at a minimum rate of 300 square feet per gallon no more than 24 hours prior to base coat applications; the base coat will be a polyurethane applied to an average thickness of 20 mils dry (20 mils wet). The wearing coat is a polyurethane, applied at an average thickness of 20 mils dry (20 mils wet) with aggregate broadcast at the rate of 10-15 pounds per 100 square feet and backrolled. For heavy traffic areas such as drive aisles, steep or spiraling ramps, ticket booths and turning areas, a second wear coat is applied at 12 mils dry (16 mils wet) with aggregate broadcast at the rate of 10 to 15 pounds per 100 square feet.

- 2.2 AGGREGATES: Supply clean, rounded, oven-dried quartz sand with a minimum size gradation of 16-30 mesh, and a minimum hardness of 6.5 per the Moh's scale, supplied in pre-packaged bags and free of metallic or other impurities. Seeding of aggregate must be even, light broadcast straight to refusal.

2.3 PERFORMANCE REQUIREMENTS

- A. It is required that, for the period of Warranty, the completed system be watertight and not deteriorate excessively under normal weather exposure, normal traffic conditions, and/or manufacturer-recommended application procedures.
- B. It is required that traffic topping work not deteriorate under spillage of motor oil, transmission fluids, and other motor vehicle operating compounds, nor for exposure to normal ice/snow melting substances not specifically excluded by manufacturer's product information.
- C. Base coat shall have a minimum tensile strength per ASTM D412 of 1,000 pounds per square inch.
- D. Top coat shall have a minimum tensile strength per ASTM D412 of 2,000 pounds per square inch.
- E. Base coat shall be capable of 350% elongation minimum, per ASTM D412.
- F. Minimum adhesion shall be one of the following:
 - 1. Base Coat - 20 pounds per square inch per ASTM D903.
 - 2. Base Coat - 25 pounds per square inch per ASTM C794.
 - 3. Base Coat - 250 pounds per square inch per ASTM D4541.
 - 4. Failure in Concrete when Tc is less than 6,000 pounds per square inch.
- G. Total System Requirements
 - 1. Minimum dry film thickness of the system without aggregate in parking areas is 40 mils.
 - 2. Minimum dry film thickness of the system without aggregate in heavy wear areas is 50 mils.
 - 3. All systems shall be wear balanced for parking stall and drive aisle applications according to the manufacturer's recommendations.

PART 3 - EXECUTION

- 3.1 PREPARATION
 - A. Bond Test: Prior to membrane application, perform a direct tensile pull test per ASTM C1683 (Standard Test Method for Tensile Strength of Concrete Surfaces and the Bond Strength or Tensile Strength of Concrete Repair and Overlay Materials by Direct Tension (Pull-Off Method)) as follows, unless more are required by product manufacturer:
 - 1. One (1) test per each 7,500 square feet of existing coat to be recoated.
 - a. One (1) additional test shall be performed for each failure in same area tested.
 - 2. One (1) test for every four (4) areas requiring removal of existing membrane base coat and/or installation of joint sealants. Each joint and each patch cover shall be tested.
 - a. One (1) additional test shall be performed for each failure in same area.
 - B. Install cant strips and similar accessories as recommended by the waterproofing manufacturer, in the manner recommended by the manufacturer.
 - C. Verify substrate has properly cured. If efflorescence is present, mechanically remove it before proceeding.
 - 1. Concrete should have a minimum compressive strength of 3,000 psi and be cured for a minimum of 28 days or 80 percent of design strength.

END OF SECTION 075700